


DX 78-1

Barton KANSAS

Section 34 Township 16 Range 12W

Well No. 1 Schneewis

Company C. C. Nelson

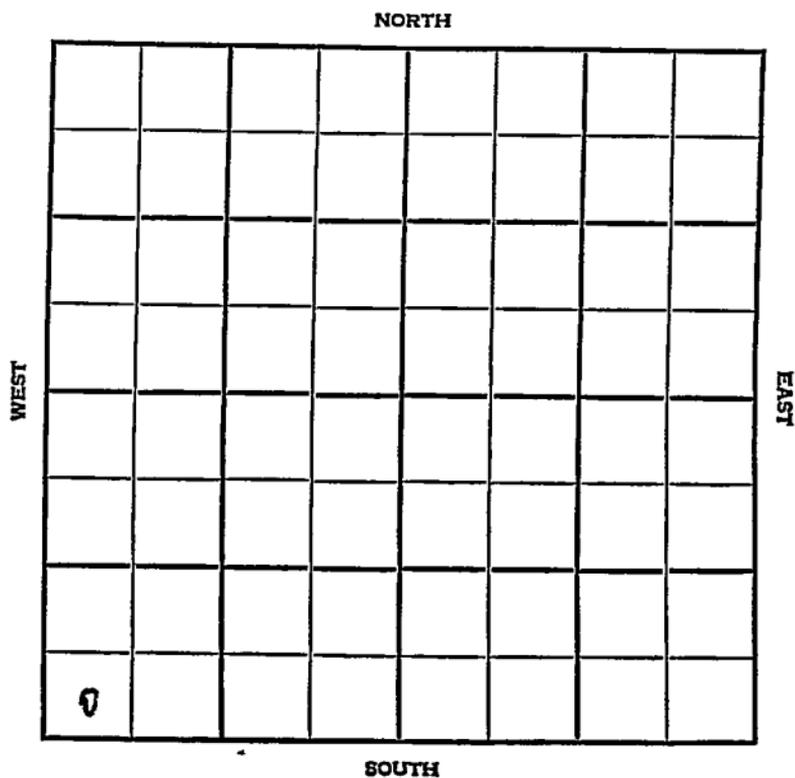


SEC.	TWP.	R.
34	16	12W

WELL NO. #1 Schneweis FARM

COMPANY C.C. Nelson

CONTRACTOR Lewis Drlg.

_____ Ft. from N. Line
 330 _____ Ft. from S. Line
 _____ Ft. from E. Line
 330 _____ Ft. from W. Line
 SW SW SW

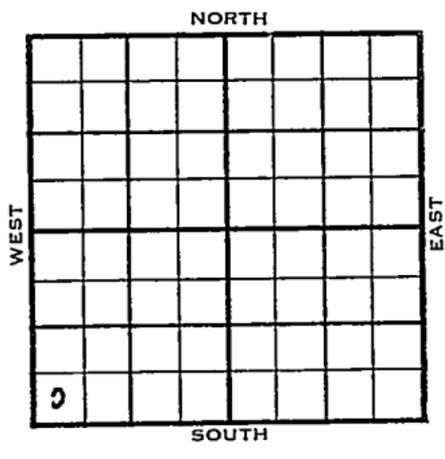

1955	ELEVATION 1868'	REPORT
------	--------------------	--------

1/12 M I R
 2/2 Spud 1-11-55
 D & A
 TD 3333'
 8-5/8" @ 272'
 Anhy 920' Heeb 2966' Br. Lime 3058'
 Lans 3074' Arb. 3328'
 TD 3331'
 5" @ 3328'
 DD 3333'
 D & A

ABANDONED

