

KANSAS

Form 51-5M-7-30-Plate

Russell


O.W.P.B.

Section 8 Township 15 Range 13-W

Well No. #10 Rein

Company Skelly

NORTH ~~Coralena~~ ^{TRAPP} Pool

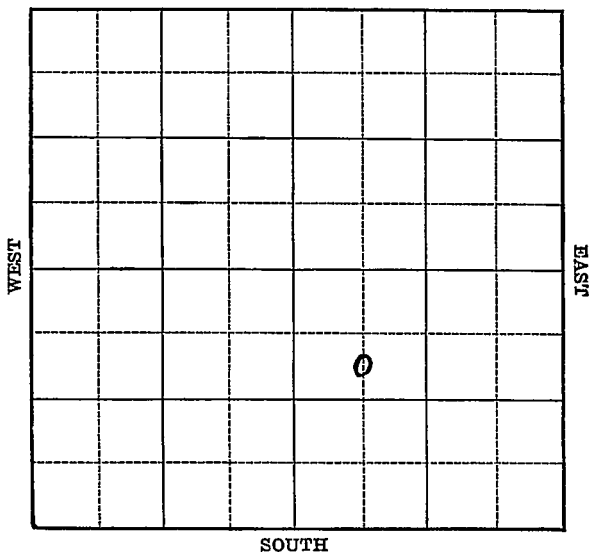

Sec. 8 Twp. 15 R. 13-WWell No. #10 Rein Farm

Skelly

Company

~~(Cordena)~~
*Trap Pool*990

Ft. from N. Line

Ft. from S. Line

1964


Ft. from E. Line

660

Ft. from W. Line

C 5/2 NWSE

Elev. 1812

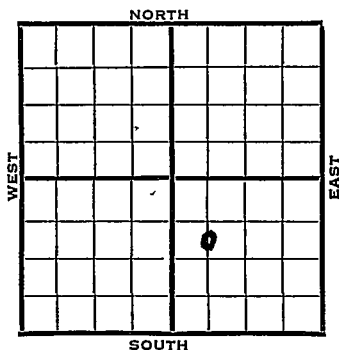

1940	REPORT
4/17	Location
4/25	8" - 324' WOC.
5/2	Drlg. 2682'
5/9	Lansing 2975' Sat. 3005-24'
	Sat. 3073-95' Arb. 3284-90' TD
	RUST.
5/16	P.B. 3027½' 72 shots 2995-3008
	5000 acid. Swab 84 bbls. in 5
	hours.
5/22	Lans. 2975'
	Arb. 3284'
	5" - 3284'
	T.D. 3290'
	P.B. to 3027½'
	12 shots 3002-06'
	72 shots 2995-3008'
	5000 acid.
	Potential 891 bbls., pump.
	COMPLETED
	OVER

1954
7/28

O. W. P. B.

Oil well TD 3290 Top 2664
Heeb 2900 Tor. 2917 Doug. 2932
Lans. 2967 Arb. 3284
5" @ 3284 OTD 3290 PB 2932
84/2918-30 5000 A PB 2876
42/2865-71 500 A S/2 BO 4 BW 2 hr.
PB 2861 106/2843-60 PB 2857
86/2843-55 3000 A P/18 BO 35 BW
14 hr. PB 2695 27/2681-84
500 A DP 2930 P/32 BO 20 BWPD
Comp.

FIRST REPORT

COMPLETED

Map No. 73 Sec. 8 Twp. 15 R. 13WWell No. 10 kein
Skelly CompanyFIRST REPORT Contractor

C S L NW SE

990 Ft. from N. Line Ft. from S. Line1964 Ft. from E. Line Ft. from W. Line

CORALENA POOL

SECTION PLAT

Location XRig up

Drilling and Remarks:

RECORD

Cased in., ft.Sand Gas Oil Total Depth

PRODUCTION

1st 24 hrs. Nat. 1st 24 hrs. after shot Gas Cu. Ft.Dry Hole Abandoned

Date

APR 17 1940₁₉S. J. LEWIS Scout

KANSAS

Map No. 73 Sec. 8 Twp. 15 R. 13WWell No. 10 Rein
Skelly Company

Contractor

COMPLETED

C S L NW SE

SECTION PLAT

		Q	

990 Ft. from N. Line Ft. from S. Line1964 Ft. from E. Line Ft. from W. Line

Coralena pool

Location Rig up

Drilling and Remarks:

*Lans 2975**Ar 8284**5" @ 3284**P.B 3027 1/2**12 Bk to 8002-06**72 " 2995-3008**5000 acid**Pump. 591 Psf.*

RECORD

Cased in., ft.Sand Gas Oil Total Depth 3290

PRODUCTION

1st 24 hrs. Nat. 1st 24 hrs. after shot Gas Cu. Ft.Dry Hole Abandoned

Date

MAY 22 1940

19

S. J. LEWIS Scout

J. G. McGEHEE