


Section 34 Township 16 Range 12-W

Well No. #1 J L Schenwiss "A"

Company C E Ash

Kraft-Prusa Pool
NORTH

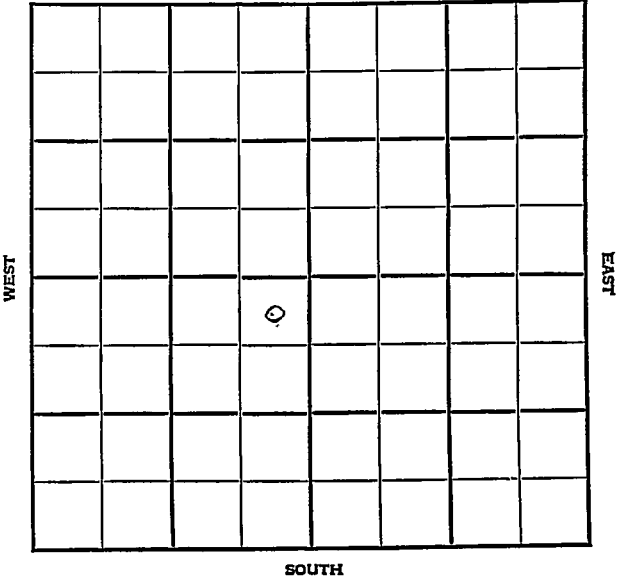

Sec. 34 Twp. 16 R. 12W

Well No. #1 J. L. Schenwiss "A" Farm


C. E. Ash Company
Kraft-Prusa

330 Ft. from N. Line

_____ Ft. from S. Line

330 Ft. from E. Line

_____ Ft. from W. Line

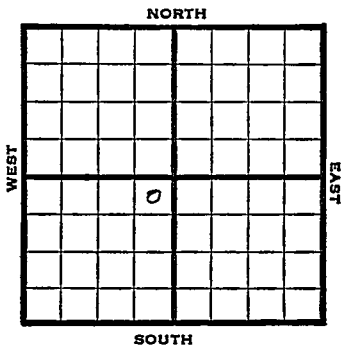

NE SW

1948 Elev 1879' REPORT

6/1 Drlg. 740'
6/9 8" @ 247'
Drlg 3050'
6/16 TD 3380' -
Lansing 3068'
Arb. 3359'
Aband.
ABANDONED

Map No. _____ Sec. 34 Twp. 16 R. 12W

Well No. 1 J. L. Schenwiss "A"

C. E. Ash Company

FIRST REPORT

Contractor

NE SW

SECTION PLAT

330 Ft. from N. Line

_____ Ft. from S. Line

330 Ft. from E. Line

_____ Ft. from W. Line

| | | | |
|--|--|---|--|
| | | | |
| | | | |
| | | o | |
| | | | |

Barton County

Location _____

Rig up _____

Drilling and Remarks:

drlg. 740

RECORD

Cased _____ in., _____ ft.

Sand _____

Gas _____

Oil _____

Total Depth _____

PRODUCTION

1st 24 hrs. Nat. _____

1st 24 hrs. after shot _____

Gas _____ Cu. Ft.

Dry Hole _____

Abandoned _____

Date

JUN 1 1948 19

S. J. LEWIS Scout

Map No. 55 Sec. 34 Twp. 16 R. 12W

Well No. 1 J. L. Schenwiss "A"

C. E. Ash Company

ABANDONED

Contractor

NE SW

E 11879

SECTION PLAT

330 Ft. from N. Line

_____ Ft. from S. Line

330 Ft. from E. Line

_____ Ft. from W. Line

| | | | |
|--|--|--|--|
| | | | |
| | | | |
| | | | |
| | | | |

Barton County

Location _____

Rig up _____

Drilling and Remarks:

Lease 3068

Ac 83359

RECORD

Cased _____ in., _____ ft.

Sand _____

Gas _____

Oil _____

Total Depth 3380

PRODUCTION

1st 24 hrs. Nat. _____

1st 24 hrs. after shot _____

Gas _____ Cu. Ft.

Dry Hole _____

Abandoned _____

Date

JUN 16 1948

19

S. J. LEWIS Scout