KANSAS

Form 51—5M—11-38—Palace

Russell

Section 7 Township 15 Range 13-W

Well No. #1 Magg

Company Haynes & Anschutz

Coralena Pool

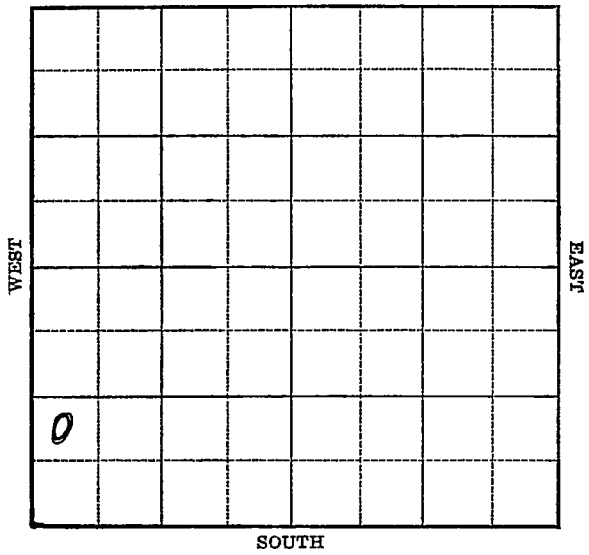

FORM 252-A 5M **KANSAS** Russell

Sec. 7 Twp. 15 R. 13 -W

Well No. #1 Magg Farm

Haynes & Anschutz Company

(Coralena)

_____ Ft. from N. Line

990 Ft. from S. Line

_____ Ft. from E. Line

330 Ft. from W. Line

Elv. 1868

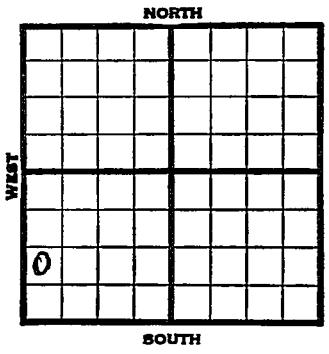

1939	REPORT
11/28	Cable.
12/7	15" - 310' Drlg. 480'
12/14	12" - 500' Anhy 855'
	Drlg. 1550'
12/21	10" - 860' Drlg. 2345'
12/28	8" - 2505' TD 2565' SD.
1940	
1/4	8" - 2555' Topeka 2770'
	Lans. 3064' Drlg. 3073'
1/11	6" - 3075' Cong. 3320'
	Arb. 3324' T.D. 3350' SD.
1/18	6" - 3090' P.B. 3120'
	500' oil 24 hours.
1/24	Arb. 3324'
	6" - 3090'
	T.D. 3350'
	P.B. to 3120'
	2000 acid.
	No shows.
	ABANDONED

Form 26—1M Bks.—2-29

Russell

KANSAS

Map No. 73 Sec. 7 Twp. 15 R. 13W

Well No. 1 Magg

Haynes & Anschutz Company

Contractor

FIRST REPORT

NW SW SW

_____ Ft. from N. Line

990 Ft. from S. Line

_____ Ft. from E. Line

330 Ft. from W. Line

CORALENA POOL

SECTION PLAT

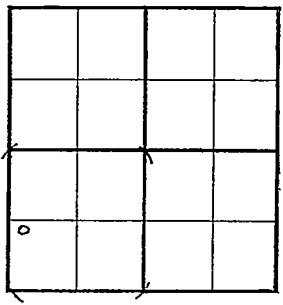

Location _____

Rig up _____

Drilling and Remarks:

Cable

RECORD

Cased _____ in., _____ ft.

Sand _____

Gas _____

Oil _____

Total Depth _____

PRODUCTION

1st 24 hrs. Nat. _____

1st 24 hrs. after shot _____

Gas _____ Cu. Ft.

Dry Hole _____

Abandoned _____

Date

NOV 28 1939 19

S. J. LEWIS Scout

Form 26—1M Bks.—2-29 Russell KANSAS

Map No. 73 Sec. 7 Twp. 15 R. 13W

Well No. 1 Magg

Haynes & Anschutz Company

Contractor

ABANDONED

NW SW SW

Ft. from N. Line

990 Ft. from S. Line

Ft. from E. Line

330 Ft. from W. Line

CORALENA POOL

SECTION PLAT

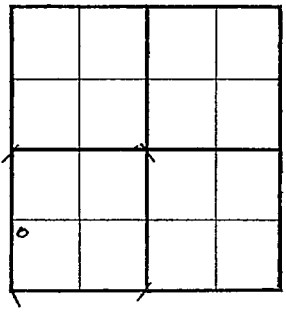

Location

Rig up

Drilling and Remarks:

Cir 8 3324
P.B 3120
6" @ 3090
2000 acid
No shows.

RECORD

Cased in., ft.

Sand

Gas

Oil

Total Depth 3350

PRODUCTION

1st 24 hrs. Nat.

1st 24 hrs. after shot

Gas Cu. Ft.

Dry Hole

Abandoned

Date

JAN 24 1940 19 S. J. LEWIS Scout