


Russell KANSAS

FORM 51 5M PETROL

Section 7 Township 15 Range 13-W

Well No. #3 Magg

Company Great Lakes Carbon

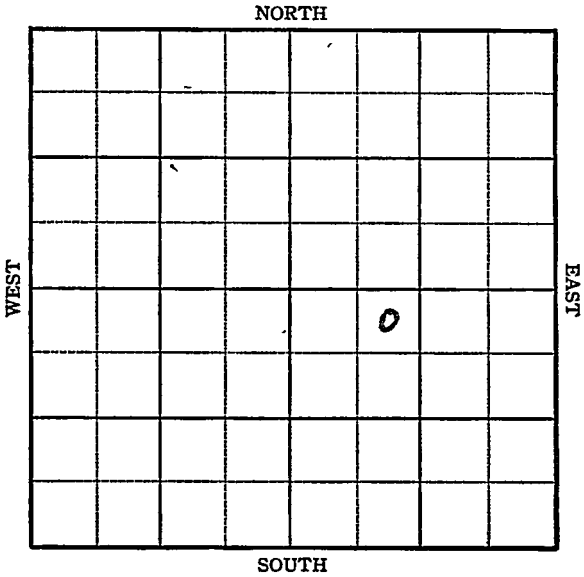

KANSAS

Russell County

Sec. 7 Twp. 15 R. 13W

Well No. #3 Magg Farm

Great Lakes Carbon Company

Trapp


330 Ft. from N. Line

         Ft. from S. Line

         Ft. from E. Line

990 Ft. from W. Line

NE NW SE

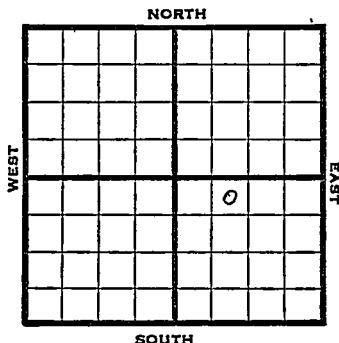

1945

Elev. 1825

REPORT

12/28 Location

1946

1/10 8" - 440' Topeka 2700'  
Drlg. 2850'

1/16

Lans 3002  
Arb. 3283  
TD 3293'

**ABANDONED**

KANSAS Kansas Pool Name TrappMap No. K-23 Sec. 7 Twp. 15 R. 13WWell No. 3 LagrGreat Lakes Carbon CompanyFIRST REPORT ContractorNE SE

## SECTION PLAT

|  |  |   |  |
|--|--|---|--|
|  |  |   |  |
|  |  |   |  |
|  |  | o |  |
|  |  |   |  |

330 Ft. from N. Line       Ft. from S. Line       Ft. from E. Line990 Ft. from W. LineRussell CountyLocation XRig up       

Drilling and Remarks:

## RECORD

Cased        in.,        ft.Sand       Gas       Oil       Total Depth       

## PRODUCTION

1st 24 hrs. Nat.       1st 24 hrs. after shot       Gas        Cu. Ft.Dry Hole       Abandoned       

Date

DEC 2 8 1945 19S. J. LEWIS Scout

KANSAS

Kansas

Pool Name TrappMap No. 73 Sec. 7 Twp. 15 R. 13WWell No. 3 Magg

Great Lakes Carbon

Company

ABANDONED

Contractor

NE NW SE

E. 1/1925

SECTION PLAT

330 Ft. from N. Line

Ft. from S. Line

Ft. from E. Line

990 Ft. from W. Line

|  |  |   |  |
|--|--|---|--|
|  |  |   |  |
|  |  |   |  |
|  |  | 0 |  |
|  |  |   |  |

Russell County

Location

Rig up

Drilling and Remarks:

*Line 3002**Cr 8283*

## RECORD

Cased \_\_\_\_\_ in., \_\_\_\_\_ ft.

Sand \_\_\_\_\_

Gas \_\_\_\_\_

Oil \_\_\_\_\_

Total Depth 3273

## PRODUCTION

1st 24 hrs. Nat. \_\_\_\_\_

1st 24 hrs. after shot \_\_\_\_\_

Gas \_\_\_\_\_ Cu. Ft.

Dry Hole \_\_\_\_\_

Abandoned \_\_\_\_\_

Date

JAN 1 6 1946

19

S. J. LEWIS

Scout