


Section 8 Township 15 Range 13-W

Well No. #8 Rein


Company Skelly

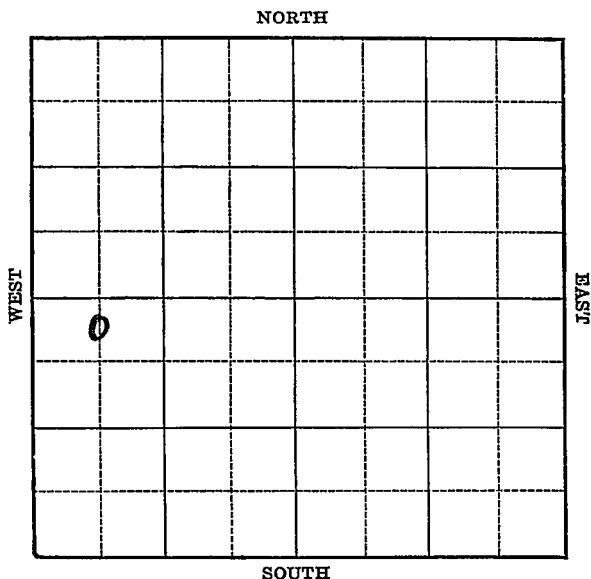

Sec. 8 Twp. 15 R. 13-WWell No. #8 Rein FarmSkelly

Company

(Coralena)

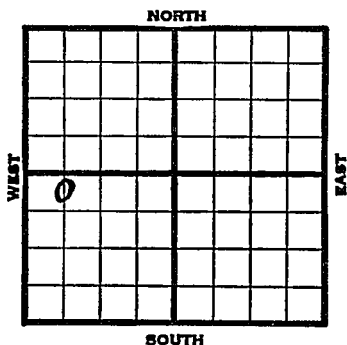330 Ft. from N. Line Ft. from S. Line Ft. from E. Line660 Ft. from W. LineCNL NWSWElev. 1785

1939	REPORT
12/6	Rotary.
12/14	10" - 272' WOC.
12/21	Drlg. 2125'
12/28	Drlg. 2965'
1940	
1/4	Lans. 2953' Pay 2977-78' T.D. 7" - 2977' RUST.
1/11	S.O. 2982' T.D. 2985' C.O.
1/18	T.D. 3003' 5000 acid. Swab 112 bbls. 9 hours. Pump 248 bbls. 4 hours. Shut down.
1/24	Lans. 2953' 7" - 2977' T.D. 3003' 5000 acid. Potential 1251 bbls., pump.
	COMPLETED
	OVER

1954
2/3

O. W. P. B.

Oil well TD 3003' Heeb 2884'
Tor. 2900' Doug. 2919' Lans. 2952'
7" @ 2977 OTD 3003' SP 2923'
128/2900-16 B/2 $\frac{1}{2}$ BOPH 2 hr.
500 A P/134 BOPD Comp.

FIRST REPORT



COMPLETED

Map No. 73 Sec. 8 Twp. 15 R. 13WWell No. 8 ReinSkelly

Company

Contractor

**FIRST REPORT
C N L NW SW**330 Ft. from N. Line Ft. from S. Line Ft. from E. Line660 Ft. from W. Line**CORALENA POOL****SECTION PLAT**

o			

Location Rig up Drilling and Remarks:

Rotary

RECORDCased in., ft.Sand Gas Oil Total Depth **PRODUCTION**1st 24 hrs. Nat. 1st 24 hrs. after shot Gas Cu. Ft.Dry Hole Abandoned

Date

DEC 6 1939

19

S. J. LEWIS Scout

Map No. 73 Sec. 8 Twp. 15 R. 13WWell No. 8 ReinSkelly Oil

Company

Contractor

COMPLETED

C N L NW SW

330 Ft. from N. Line Ft. from S. Line Ft. from E. Line660 Ft. from W. Line

CORALENA POOL

SECTION PLAT

o		.	

Location Rig up

Drilling and Remarks:

*Trans. 2953**7" C 2977**5000 acid**Pump 1251 P.S.*

RECORD

Cased in., ft.Sand Gas Oil Total Depth 3003

PRODUCTION

1st 24 hrs. Nat. 1st 24 hrs. after shot Gas Cu. Ft.Dry Hole Abandoned

Date

JAN 24 1940 19

S. J. LEWIS

Scout

O. W. P. B.

County Russell State Kansas
 Sec. 8 (Blk.) 15 (Sur.) 13W Map No.
 Operator Skelly Oil
 Well No. 8 Farm Geo. Rein
 Elev. 1785 Location C N L NW SW

FIRST REPORT

COMPLETE

330 Ft. From N Line SW
660 Ft. From W Line Quarter
 1st. Report FEB 3 1954
 Completion FEB 3 1954
 Remarks - OWPR
 Spudding Date O. W. P. B.

Drlg. Data Oil well TD 3003
Heeb. 2884 Tor. 2900 Doug. 2919
Lans. 2952 7" @ 2977 OTD 3003
SP 2923 128/ 2900+16 B/ 2 1/2 boph 2 hr.
500 A P/ 134 bopd Comp.