

KANSAS

Form 51-5M-7-39-Palace


Russell

Section 8 Township 15 Range 13-W

Well No. #9 Rein

Company Skelly

NORTH Coralena Pool

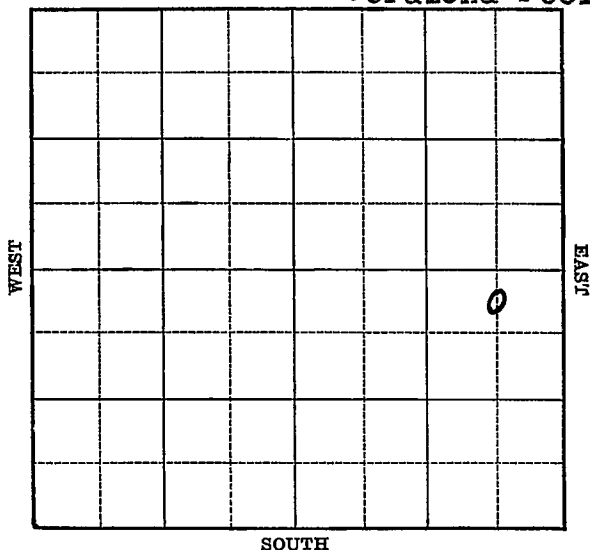

Sec. 8 Twp. 15 R. 13-WWell No. #9 ReIn FarmSkelly Company


(Coralena)

330 Ft. from N. Line

Ft. from S. Line

660 Ft. from E. Line

Ft. from W. Line

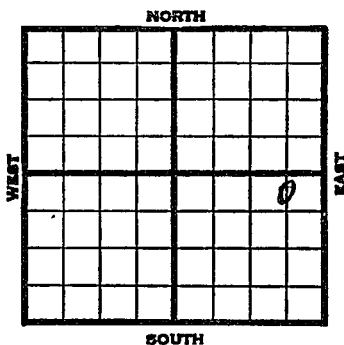

Elev. 1853

1940	REPORT
3/6	Rig roty.
3/14	8" - 320' Drlg. 895'
3/21	Drlg. 2409'
3/28	Dodge 2936' Lans. 2985'
	Granite 3234' 5" - 3231' RUST.
4/4	144 shots 3079-97'
	71 shots 3015-28' H.F.O. 9½ hrs
	7000 acid. 12 M gas.
	Flow 124 bbls. 5 hours.
4/10	Lansing 2985'
	T.D. 3234'
	7000 acid.
	4000 acid.
	Potential 2106 bbls.
	COMPLETED

Map No. 73 Sec. 8 Twp. 15 R. 13WWell No. 9 ReinSkelly

Company

Contractor

FIRST REPORT

C N L NE SE

SECTION PLAT

330 Ft. from N. Line

_____ Ft. from S. Line

660 Ft. from E. Line

_____ Ft. from W. Line

			o

CORALENA POOL

Location _____

Rig up _____

Drilling and Remarks:

Rig Roty

RECORD

Cased _____ in., _____ ft.

Sand _____

Gas _____

Oil _____

Total Depth _____

PRODUCTION

1st 24 hrs. Nat. _____

1st 24 hrs. after shot _____

Gas _____ Cu. Ft.

- Dry Hole _____

Abandoned _____

Date

MAR 6 1940S. J. LEWIS Scout

Map No. 73 Sec. 8 Twp. 15 R. 13WWell No. 9 ReinSkelly Company

Contractor

COMPLETED

C N L NE SE

330 Ft. from N. Line Ft. from S. Line660 Ft. from E. Line Ft. from W. Line**SECTION PLAT**

			o

CORALENA POOLLocation Rig up

Drilling and Remarks:

7000 acid
4000 acidpot. 2106 lbs.**RECORD**Cased in., ft.Sand Lanier 2985Gas Oil Total Depth 3234**PRODUCTION**1st 24 hrs. Nat. 1st 24 hrs. after shot Gas Cu. Ft.Dry Hole Abandoned

Date

APR 10 1940 19S. J. LEWIS Scout