


Section 7 Township 15 Range 13W

Well No. #2 Maag

Company Cities Service

Trapp Pool

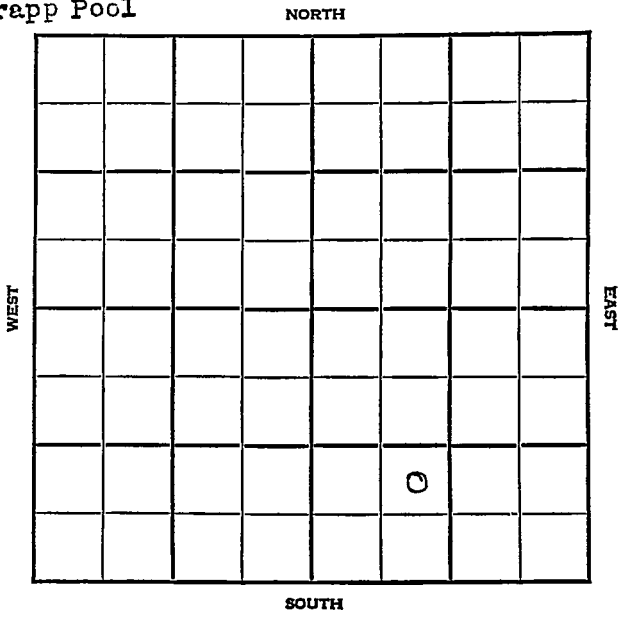

KANSAS

Russell ✓

Sec. 7 Twp. 15 R. 13W

Well No. #2 Maag Farm

Cities Service Company


Trapp Pool

Ft. from N. Line

990' Ft. from S. Line

Ft. from E. Line

990' Ft. from W. Line

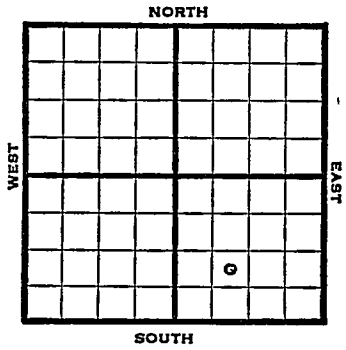

NE SW SE

1948 Elev. 1812' REPORT

2/18 Location

2/25 RUR

3/3 10" @ 546'  
Drlg. 925'

3/10 Drlg. 3104'

3/17 Topeka 2676'  
Lansing 2989'  
Arbuckle 3256'  
TD 3260'  
7" @ 3257'  
RUST

3/24 "

3/31 "

4/7 56 shots 3009-23' - 3000 acid  
Swb. 120 bbls. oil 24 hrs.

4/14 Arb. 3256'  
7" @ 3256'  
Lans. 2989'  
Perf. Lans. 3000 acid  
Pump 116 Pot 40.9 Gr.  
TD 3260'  
Comp.

COMPLETED

Map No. \_\_\_\_\_ Sec. 7 Twp. 15 R. 13W

Well No. 2 Maag

Cities Service \_\_\_\_\_ Company

**FIRST REPORT**

Contractor \_\_\_\_\_

NE SW SE

**SECTION PLAT**


\_\_\_\_\_ Ft. from N. Line

990 Ft. from S. Line

\_\_\_\_\_ Ft. from E. Line

990 Ft. from W. Line

Russell County

Location X

Rig up \_\_\_\_\_

Drilling and Remarks:

**RECORD**

Cased \_\_\_\_\_ in., \_\_\_\_\_ ft.

Sand \_\_\_\_\_

Gas \_\_\_\_\_

Oil \_\_\_\_\_

Total Depth \_\_\_\_\_

**PRODUCTION**

1st 24 hrs. Nat. \_\_\_\_\_

1st 24 hrs. after shot \_\_\_\_\_

Gas \_\_\_\_\_ Cu. Ft.

Dry Hole \_\_\_\_\_

Abandoned \_\_\_\_\_

Date

FEB 18 1948 19 \_\_\_\_\_

S. J. LEWIS

Scout

Map No. 73 Sec. 7 Twp. 15 R. 13W

Well No. 2 Maag

Cities Service Company

**COMPLETE**

Contractor

NE SW SE

*E1,1872*

SECTION PLAT


\_\_\_\_\_ Ft. from N. Line

990 Ft. from S. Line

\_\_\_\_\_ Ft. from E. Line

990 Ft. from W. Line

Russell County

RECORD

Location \_\_\_\_\_

Cased \_\_\_\_\_ in., \_\_\_\_\_ ft.

Rig up \_\_\_\_\_

Sand \_\_\_\_\_

Drilling and Remarks:

Gas \_\_\_\_\_

*Cor 3256*

Oil

*7" @ 3256*

Total Depth 3260

*Loss 2989*

*Perf. Loss.*

PRODUCTION

1st 24 hrs. Nat. \_\_\_\_\_

1st 24 hrs. after shot \_\_\_\_\_

Gas \_\_\_\_\_ Cu. Ft.

Dry Hole \_\_\_\_\_

Abandoned \_\_\_\_\_

*stocacid*

*Pump 116 PD*

*HO E. L.*

Date

APR 14 1949 19

S. J. LEWIS Scout