

Russell


Form 51-5M 5-37 Petrol

KANSAS

Section 7 Township 15 Range 13-W

Well No. 1 - Maag

Company Cities Service Oil

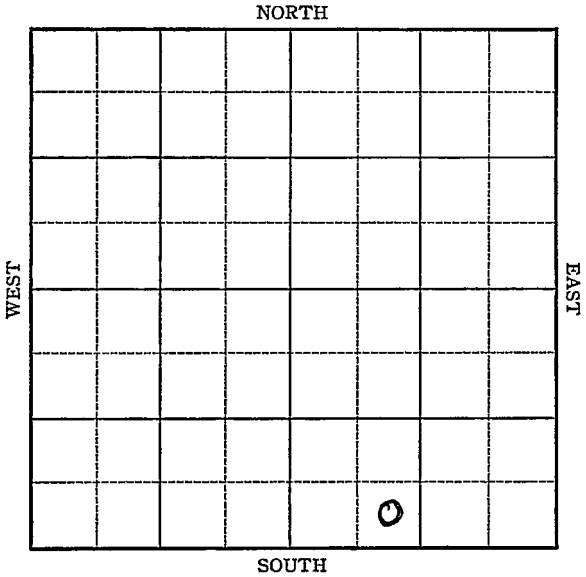

Sec. 7 Twp. 15 R. 13-W

Well No. #1 Maag Farm

Cities Service Oil Company


\_\_\_\_\_ Ft. from N. Line

330 Ft. from S. Line

\_\_\_\_\_ Ft. from E. Line

990 Ft. from W. Line

Elev. 1816

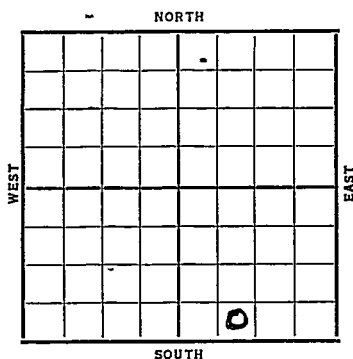

Date	REPORT
1937	
8/18	B.R.R.
8/28	T.D. 385'. Reaming.
9/3	12" @ 372'. Drlg. 1875'.
9/10	K.C. 3001'. Drlg. 3010'.
	No shows reported.
9/17	<del>REKEX</del> Coring 3292'.
9/24	Sil. 3291'. T.D. 3322'.
	P.B. 3097'.
10/2	7" @ 3097'. WOC.
10/8	Perforated pipe with 50 shots
	at 3023-42'. 6000 acid.
	Pumped 157 B.O. & 20 B.W. in 24
	hours.
	<b>OVER</b>

1937

10/13 7" @ 3097' .

Sil. 3291' .

T.D. 3322' .

P.B. 3097' .

Perforated pipe with 50 shots 3023-42" .

6000 acid.

Potential 300 bbls. oil plus 2% water.

COMPLETED

Russell KANSAS

Map No. 73 Sec. 7 Twp. 15 R. 13<sup>w</sup>Well No. 1- massCities Service Oil Company

Contractor

## FIRST REPORT

\_\_\_\_\_ Ft. from N. Line

530 Ft. from S. Line

\_\_\_\_\_ Ft. from E. Line

990 Ft. from W. Line

## SECTION PLAT

			0

Location \_\_\_\_\_

Rig up \_\_\_\_\_

Drilling and Remarks:

BRR

## RECORD

Cased \_\_\_\_\_ in., \_\_\_\_\_ ft.

Sand \_\_\_\_\_

Gas \_\_\_\_\_

Oil \_\_\_\_\_

Total Depth \_\_\_\_\_

## PRODUCTION

1st 24 hrs. Nat. \_\_\_\_\_

1st 24 hrs. after shot \_\_\_\_\_

Gas \_\_\_\_\_ Cu. Ft.

Dry Hole \_\_\_\_\_

Abandoned \_\_\_\_\_

Date

AUG 18 1937 19H. D. Hatfield Scout

Russell **KANSAS**

Map No. \_\_\_\_\_ Sec. 7 Twp. 15 R13W

Well No. 1 Maag

Cities Service Company

Contractor

**COMPLETED**

**SE SW SE**

1 Ft. from N. Line

330 Ft. from S. Line

\_\_\_\_\_ Ft. from E. Line

990 Ft. from W. Line

**SECTION PLAT**

			0

Location \_\_\_\_\_

Rig up \_\_\_\_\_

Drilling and Remarks:

*P.B. 3097.*

*Perforated pipe  
w/ 50 shots 3023-42  
6000 Acid*

*Pot - 300  
Plus*

*2% wat.*

**RECORD**

Cased 7 in., 3097 ft.

Sand Sil 3291

Gas \_\_\_\_\_

Oil \_\_\_\_\_

Total Depth 3322

**PRODUCTION**

1st 24 hrs. Nat. \_\_\_\_\_

1st 24 hrs. after shot \_\_\_\_\_

Gas \_\_\_\_\_ Cu. Ft.

Dry Hole \_\_\_\_\_

Abandoned \_\_\_\_\_

Date

**OCT 13 1937**

**H. D. Hatfield** Scout