


Section 8 Township 15 Range 13WWell No. 13⁺ ReinCompany Skelly~~Tropp~~

NORTH

WEST

EAST

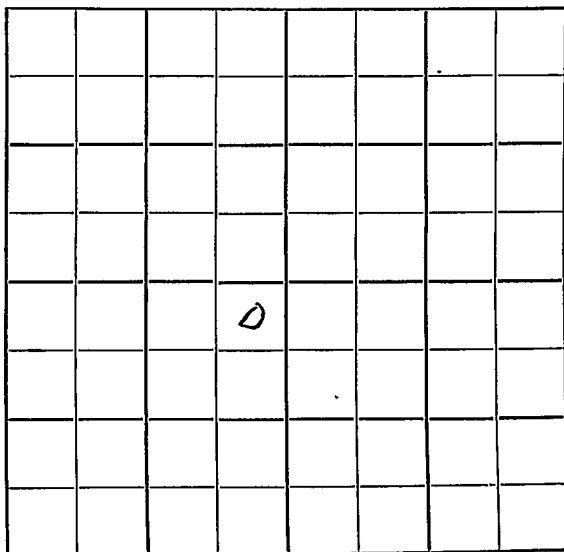

SOUTH

O. W. P. B Russell

KANSAS

Sec. 8 Twp. 15 R. 13WWell No. #13 Rein Farm

Skelly


Company

~~Tropp Pool~~330' Ft. from N. Line

Ft. from S. Line

330' Ft. from E. Line

Ft. from W. Line

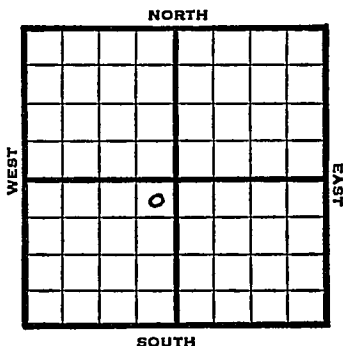

NE NE SW

1949 Elev 1738' REPORT

7/20 Anhy 702'
8" @ 709'
Drlg. 1615'

7/27 Lansing 2896'
TD 2915'
5"@ 2913'

8/3 "

8/10 TD 2995'
Lansing 2896'
5"@ 2913
4000 Acid
Pump 348 Oil / 6 W Pot
40⁹ Gr.
Comp

COMPLETED

1956

O. W. P. B

3-7 H. 2828
OTD 2995 Tr. 2845
5" @ 2913 Dg. 2862
DD 3031, L. 2896
Dry, 72/ 2895-2902, 1500 A
S/ 1 bo 3 hrs., PB 2860, 63/2846-53
500 A
S/ 3 bo 6 hrs., 1500 A,
S/ 3 bo, 1 $\frac{1}{2}$ baw 3 hrs.
sd-oil frac,
Comp. 69 bopd, 26 bw

**FIRST REPORT
COMPLETED**

Kansas

Tropp Pool

Map No. _____ Sec. 8 Twp. 15 R. 13W

Well No. 13 Rein _____

Skelly _____

Company _____

Contractor _____

NE SW


FIRST REPORT
SECTION PLAT

330 Ft. from N. Line

Ft. from S. Line

330 Ft. from E. Line

Ft. from W. Line

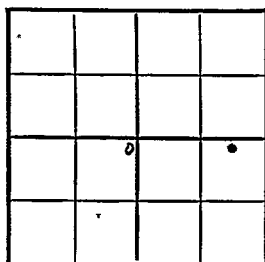

Russell County

Location _____

Rig up _____

Drilling and Remarks:

any 702

8" @ 709

1615

RECORD

Cased _____ in. _____ ft.

Sand _____

Gas _____

Oil _____

Total Depth _____

PRODUCTION

1st 24 hrs. Nat. _____

1st 24 hrs. after shot _____

Gas _____ Cu. Ft.

Dry Hole _____

Abandoned _____

Date

JUL 20 1949

19

Scout

Kansas

Map No. K 73 Sec. 8 Twp. 15 R. 13WWell No. 13 Rein

Skelly _____ Company

COMPLETE

Contractor


NE SW

E1. 1738
SECTION PLAT330 Ft. from N. Line

_____ Ft. from S. Line

330 Ft. from E. Line

_____ Ft. from W. Line

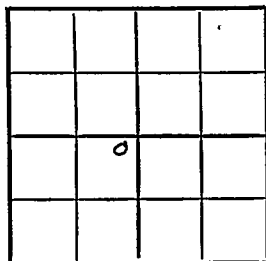

Russell County

RECORD

Location _____

Cased _____ in. _____ ft.

Rig up _____

Sand _____

Drilling and Remarks:

Gas _____

Line 2896

Oil _____

*5" @ 2913*Total Depth 2995*4000 feet***PRODUCTION***Run 348 oil + 614*

1st 24 hrs. Nat. _____

1st 24 hrs. after shot _____

Gas _____ Cu. Ft. _____

Dry Hole _____

Abandoned _____

Date

AUG 10 1949 19S. J. LEWIS

Scout

O. W. P. B

OWPB

FORM 513 REV SUNRAY

County Russell Elev. 1738
 Sec. 8 Twp. 15 Rge. 13W
 Company Skelly Oil
 Farm Name G. Rein No. 13

TOPS

DEPTH

LOG

DATUM

Loc. in Sec.

Anh.				NE NE SW
Tp.				
H.	2828			
Tr.	2815			
Dg.	2862			
Bl.				
L.	2896			
K.C.				Geol.
B.K.C.				Contr.
Ce.				
C.				
M.				
M.				Pool
K.				
Mz.				
Ma.				
V.				
S.				
S.				
A.				
R.				
Pe.				
G.				
T.D.				

FIRST REPORT
 ONAR 4 '56
 COMPLETE

Date Comm.

OTD 2995 5" @ 2913 DD 3031 dry

72/ 2895-2902 1500 A S/ 1 bo 3 hr.

PB 2860 63/ 2846-53 500 A

S/ 3 bo 6 hr. 1500 A S/ 3 bo 1½ baw

3 hr. sel-oil-frac Comp. 69 bopd 26 baw