

Russell

KANSAS


FORM 51

Section 7 Township 15 Range 13W

Well No. #13 M.E. Anderson

Company Skelly Oil

NORTH

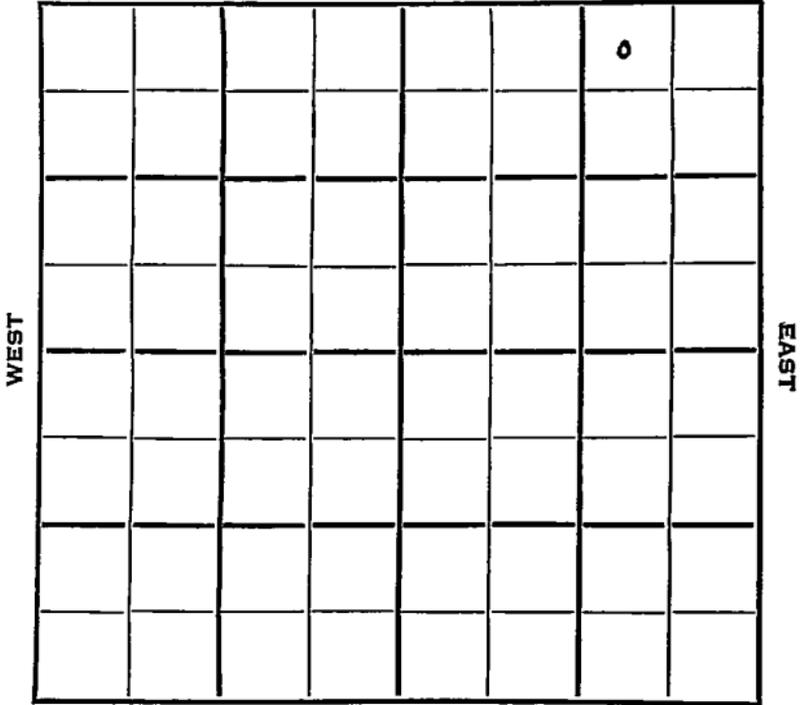

SOUTH

SEC. 7	TWP. 15	R. 13W
-----------	------------	-----------

WELL NO.

#13 M.E. Anderson

FARM

COMPANY

Skelly Oil

CONTRACTOR

Trapp Pool

NORTH

330


Ft. from N. Line

Ft. from S. Line

990

Ft. from E. Line

Ft. from W. Line

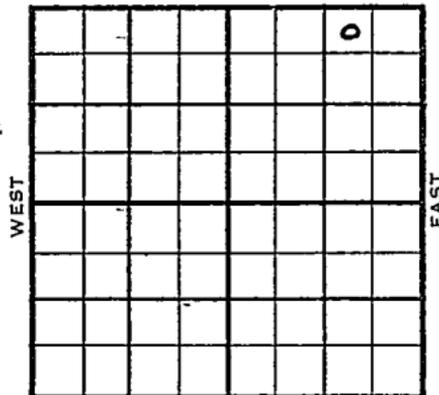

NW NE NE

SOUTH

1954

ELEVATION

1772'

REPORT

4/7

Spud 4-3-54

Anhy 755'

8" @ 765'

WOC.

5/26

Spud 4-3-54

Oil Well

TD 3272'

Anhy 755'

8" @ 765'

Lans 2953'

DST 2890-3017', opn 1 hr., rec. 102'

gcm, 102#

Tarkio 2377', Top 2648', Heeb 2886',

Tor 2904'

DST 2929-79', opn 1 hr., rec. 54' socm,

620#

Cong. 3228', Arb. 3251'

TD 3272'

5" @ 3272'

CO to 3265

21/3228-35, 71/3223-35, 500A,

S/56 bo 2 bw 8 hrs., 18/3235-41,

9/3241-44, 24/3240-44, 300A

6 gwph 750A, 18 gwph

PB 3160, 90/3137-47, 500A, 10 gwph

4 hrs., PB 2920', 72/2902-10, 500A

1 go 5 gwph

A-frac

OVER

(Information Brought Forward)

1954
5/26

B/15 go 8 gwph 5 hrs.

1500A

S/9 bw 13 hrs.

CO 3160

SP 3035'

90,2980-90

750A

S/2 bw 15 hrs.

CO to 3035'

90/3020-30, 500A

S/17 bo 42 bw 5 hrs.

Comp. 14 bopd 20 bw

COMPLETED

Orig. Data

CO 3160

SP 3055

90/7 2080-90

750 A

S/

2 bw

15

hr.

Miss

to 3035

90/ 3020-30

500

A

S/

17

hr

42

bw

5

hr

Comp. 14

hr

20

bw

hr

Land Wall Map

Land Small Map

Scout Cards

[Handwritten signature]

1954

JUN 1