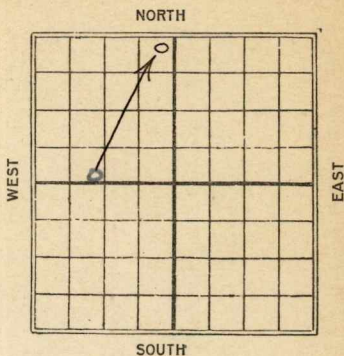


Russell

Map No. Kav Sec. 8 Twp. 12 R. 15WWell No. 1 Oswald Farm
Med. West Company330 Ft. from N. Line~~330~~ Ft. from S. Line330 Ft. from E. Line~~990~~ Ft. from W. LineDate
1925

REPORT

6/9 D. 2030.10/28 ✓ 25-20'19265/59/8 Sand 2931 to 2933
swabbed 450 bbls
24 hrs

Russell

Map No. Kansas Sec. 8 Twp. 12 R. 15 ^W

Well No. 1 Oswald Farm


Mid-West oil Company

330 Ft. from N. Line

_____ Ft. from S. Line

330 Ft. from E. Line

_____ Ft. from W. Line

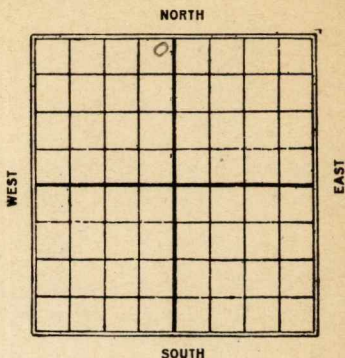

Date

REPORT

1925

9/30

Rigging up

11/18

Sand 2931-33

Swab 450 Bbls

24 hours 42 Gravity

Map No. _____ Sec. 8 Twp. 12 R. 15WWell No. 1 DonaldMidwest

Company _____

Contractor _____

FIRST REPORTS

_____ Ft. from N. Line

330 Ft. from S. Line

_____ Ft. from E. Line

990 Ft. from W. Line

SECTION PLAT

0			

Location _____

Rig up _____

Drilling and Remarks:

D, 2080

RECORD

Cased _____ in., _____ ft.

Sand _____

Gas _____

Oil _____

Total Depth _____

PRODUCTION

1st 24 hrs. Nat. _____

1st 24 hrs. after shot _____

Gas _____ Cu. Ft.

Dry Hole _____

Abandoned _____

Date

6/9 192 5 27793 Scout


Map No. KANSAS Sec. 8 Twp. 12 R. 15 W

Well 1 Oswald

Mid-West Company

Contractor

SECTION PLAT

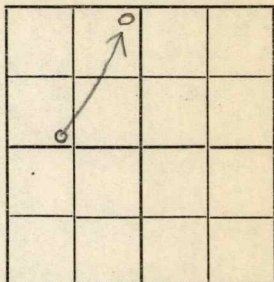

330 Ft. from N. Line

_____ Ft. from S. Line

330 Ft. from E. Line

_____ Ft. from W. Line

Correction

Location _____

Rig up _____

Drilling and Remarks:

Should be
330 from N. and
330 from E.

RECORD

Cased _____ in., _____ ft.

Sand _____

Gas _____

Oil _____

Total Depth 600

PRODUCTION

1st 24 hrs. Nat. _____

1st 24 hrs. after shot _____

Gas _____ Cu. Ft.

Dry Hole _____

Abandoned _____

Date

SEP 8

1926

192

S. J. LEWIS

Scout

Map No. KANSAS Sec. 8 Twp. 12 R. 6WWell No. 1 OawacalMid-West Company

Contractor

CORRECTION


330 Ft. from N. Line

----- Ft. from S. Line

220 Ft. from E. Line

----- Ft. from W. Line

SECTION PLAT

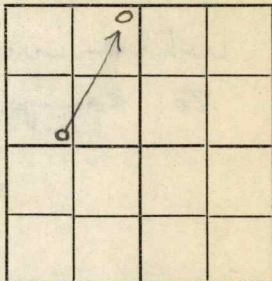

COMPLETED

Location -----

Rig up -----

Drilling and Remarks:

Sand 2933 ft.2933swabbed 4508 ft 24 hrs

RECORD

Cased ----- in., ----- ft.

Sand -----

Gas -----

Oil -----

Total Depth -----

PRODUCTION

1st 24 hrs. Nat. -----

1st 24 hrs. after shot -----

Gas ----- Cu. Ft.

Dry Hole -----

Abandoned -----

Date

SEP 8 1926

192

S. J. LEWIS

Scout

Russell
KANSAS
 Map No. _____ Sec. 8 Twp. 12 R. 15W

Well No. 1 Oswald.

Mich-Hes & Oil Company

Contractor

SECTION PLAT

	0		

330 Ft. from N. Line

_____ Ft. from S. Line

330 Ft. from E. Line

_____ Ft. from W. Line

FIRST REPORT

RECORD

Location _____

Cased _____ in., _____ ft.

Rig up _____

Sand _____

Drilling and Remarks:

Gas _____

Oil _____

Total Depth _____

PRODUCTION

1st 24 hrs. Nat. _____

1st 24 hrs. after shot _____

Gas _____ Cu. Ft.

Dry Hole _____

Abandoned _____

Date

SEP 30 1925

S. J. LEWIS

192

Scout

Map No. **KANSAS** Sec. *8* Twp. *12* R. *15W*Well No. *1 Oswald**Mid-West Oil* Company

Contractor

SECTION PLAT

	<i>0</i>		

330 Ft. from N. Line

Ft. from S. Line

330 Ft. from E. Line

Ft. from W. Line

COMPLETED

Location

Rig up

Drilling and Remarks:

*Sand 2931 to 2933**Swabbed 450**4 1/2 - 24 hrs**42.° Gr.*

RECORD

Cased _____ in., _____ ft.

Sand _____

Gas _____

Oil _____

Total Depth _____

PRODUCTION

1st 24 hrs. Nat. _____

1st 24 hrs. after shot _____

Gas _____ Cu. Ft.

Dry Hole _____

Abandoned _____

Date

NOV 18 1925

S. J. LEWIS

Scout

1st report shows that
well Located e.g. w. - n. w.

Please attach correction
ticket moving over
wherever you want
to complete.

Thanks.

Sam

Returned.....
Cards.....
Tracing.....
France Map.....
Scarborough Map.....
Moody Map.....
Scarborough Plat Book.....
Moody Plat Book.....

x no wall map