

KANSAS


Russell

Section 8 Township 15 Range 13-W

Well No. #11 Rein

Company Skelly

Trapp pool

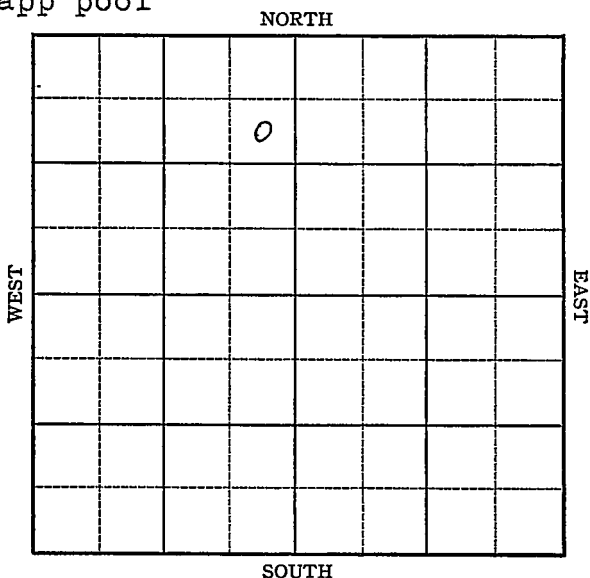

KANSAS

Russell

Sec. 8 Twp. 151. R. 13W

Well No. #11 Rein Farm

Skelly Company


Trapp Pool

990 Ft. from N. Line

Ft. from S. Line

330 Ft. from E. Line

Ft. from W. Line

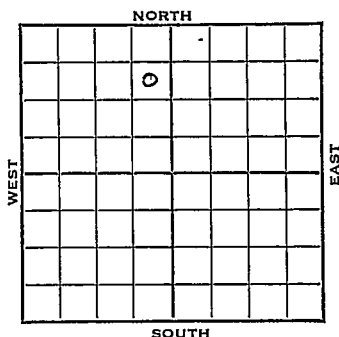

SE NE NW Elev. 1735

1942	REPORT
11/10	Location
11/18	"
11/24	Rotary
12/2	10" 291 Drlg. 1760
12/9	Drlg. 2775
12/16	Dodge 2830 Lans 2390 Sat Arb 3182 TD 3202 Sat 6" @ 32-2 Rust.
12/22	" "
12/29	" "
1943	
1/6	" "
1/13	TD 3250' 2100' oil 32 hrs.

U L R

1943 TD 3250'.

1/20 Lams 2396
Arb. 3132
6" Casing set 3202
P.B. 3151
47' shots 2928-387
4000 acid.
Pump 231 Pot.
35- Gravity
TD 3202'

COMPLETED

Rus sell

KANSAS

Map No. 73 Sec. 8 Twp. 15 R. 13WWell No. 11 ReinSkelly CompanyFIRST REPORT Contractor

SE NE NW

990 Ft. from N. Line Ft. from S. Line330 Ft. from E. Line Ft. from W. Line

SECTION PLAT

		o	

TRAPP POOL

Location XXXRig up

Drilling and Remarks:

RECORD

Cased in., ft.Sand Gas Oil Total Depth

PRODUCTION

1st 24 hrs. Nat. 1st 24 hrs. after shot Gas Cu. Ft.Dry Hole Abandoned

Date

NOV 11 1942 19 S. J. LEWIS Scout

Russell

KANSAS
 Map No. 73 Sec. 8 Twp. 15 R. 13W

Well No. 11 Rein

Skelly Oil


Company

COMPLETED

Contractor

SE NE NW

SECTION PLAT

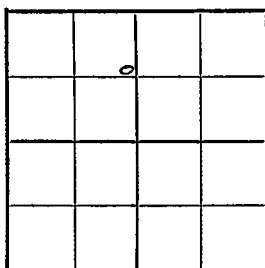990 Ft. from N. Line Ft. from S. Line330 Ft. from E. Line Ft. from W. Line

TRAPP POOL

Location Rig up

Drilling and Remarks:

*Liams 2896**CE 83182**6" @ 3202**PM 3151**474 hrs to 2928-38**4000 acw**Pump 231 P.Y.*

RECORD

Cased in., ft.Sand Gas Oil Total Depth 3202

PRODUCTION

1st 24 hrs. Nat. 1st 24 hrs. after shot Gas Cu. Ft.Dry Hole Abandoned

Date

35th Dec

JAN 20 1943

19

S. J. LEWIS

Scout