

Section 9 Township 15 Range 13W

Well No. #10 A.C. Rogg

Company Shields Oil

NORTH

0							

WEST

EAST

SOUTH


SEC	TWP	R
9	15	13 W

WELL NO \_\_\_\_\_  
 COMPANY # 10 A. C. Rogg FARM

CONTRACTOR Shields Oil

Shields  
 Hall-Gurney Pool

\_\_\_\_\_ Ft from N. Line  
 990 \_\_\_\_\_ Ft from S Line  
 \_\_\_\_\_ Ft from E Line  
 330 \_\_\_\_\_ Ft from W Line

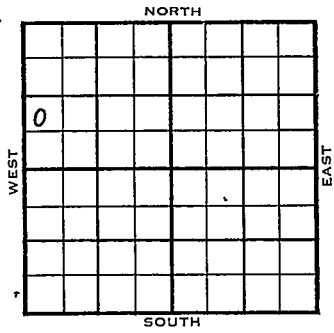

NW SW NW

	ELEVATION	REPORT
1954	1862'	
1/27	Location	
2/3	"	
2/10	12" @ 430 Drlg. 505'	
2/17	10" @ 827' Anhy 819' Drlg. 1470'	
2/24	Drlg. 2325'	
3/3	Tarkio 2395' 1/4 M gas 8" @ 2519' Drlg. 2575'	
3/10	Top 2958' Heeb 2962' Dodge 2990 Lans. 3025' 7" @ 3148 Drlg. 3170'	
3/17	Arb. 3304 TD 3313 5" @ 3310 FU 2400' oil 6 hrs while pulling 7" casing.	
3/24	NR	

LOWER

1954

3/31 Spud 2-5-54  
OilWell  
TD 3313'  
12" @ 430'  
10" @ 827'  
Anhy 819', Tarkio 2395',  
8" @ 2519'  
Top 2958', Heeb 2962', Dodge 2990'  
Lans 3025',  
7" @ 3148'  
Arb 3304'  
TD 3313'  
5" @ 3310'  
FU 2400' oil 6 hr.  
CO to 3313'  
FU 2500' oil  
Comp 25 bopd.

**COMPLETED**



County Russell State Kansas

Sec. 9 (Blk Twp) 15 (Sur. Rge) 13W Map No.

Operator Shields Oil

Well No. 10 Farm A. C. Rogg

Elev. 1862 Location NW SW NW


990 Ft. From S Line NW

330 Ft. From W Line Quarter

Ist. Report

Completion MAR 31 1954

Remarks Hall-Gurney Pool

Shields - Contr.

Spudding Date 2-5-54

Drilg. Data Oil well TD 3313

12" @ 430 10" @ 827 Anhy 819

Tarkio 2395 8" @ 2519 Top. 2958

Heeb. 2962 Dodge 2990 Lans. 3025

7" @ 3148 Arb. 3304 TD 3313 5" @ 3310

FU 2400' oil 6 hr. CO to 3313

FU 2500' oil Comp. 25 bopd

J. G. McGEHEE