


Map No. Kan Sec. 28 Twp. 33 R. 3^E

Well No. 9 Caldwell Farm
Waite Phillips Company

990 Ft. from N. Line
~~355~~ Ft. from S. Line
~~325~~ 380 Ft. from E. Line
 _____ Ft. from W. Line

B

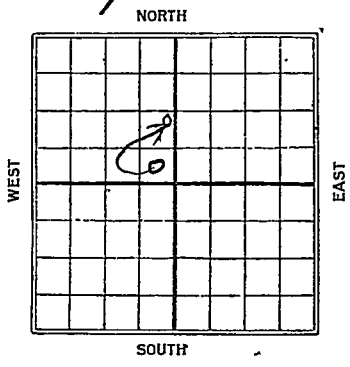

Date	REPORT
1925	
7/22	Location
7/29	Spudding.
8/7	785'
8/14	1525'
8/19	1800'
8/26	2050
9/2	2340'
9/4	2640'
9/16	2860'
9/24	set 6" - 2985'
9/30	3242 1/2
10/1	TB 3245 Gas 3256 Oil 3260 in sand 3270 T.D. 200' oil.
10/13	F 3245 Gas 3256 Oil 3260 T.D. 3270 in sand shot 5-10-5 ± 20 gals Pump 62 Bbls

Map No. **KANSAS** Sec. **28** Twp. **33** R. **3E**

Well No. **9 Caldwell**

Walter Phillips Company

Contractor

FIRST REPORT

SECTION PLAT

----- Ft. from N. Line

365

----- Ft. from S. Line

325

----- Ft. from E. Line

----- Ft. from W. Line

		0	

Location **✓✓** -----

Rig up -----

Drilling and Remarks:

RECORD

Cased ----- in., ----- ft.

Sand -----

Gas -----

Oil -----

Total Depth -----

PRODUCTION

1st 24 hrs. Nat. -----

1st 24 hrs. after shot -----

Gas ----- Cu. Ft.

Dry Hole -----

Abandoned -----

Date **JUL 22 1925**

M. A. BENEAR

Map No. KANSAS Sec. 28 Twp. 33 R. 3E

Well No. #9 Caldwell

Harte Phillips Company

Contractor

Collection

SECTION PLAT

----- Ft. from N. Line

990 Ft. from S. Line

380 Ft. from E. Line

----- Ft. from W. Line

	<i>70</i>		

Location -----

Rig up -----

Drilling and Remarks:

*This well is
asked above
instead as reported
990 S. & 990 E. line*

RECORD

Cased ----- in., ----- ft.

Sand -----

Gas -----

Oil -----

Total Depth -----

PRODUCTION

1st 24 hrs. Nat. -----

1st 24 hrs. after shot -----

Gas ----- Cu. Ft.

Dry Hole -----

Abandoned -----

Date

AUG 12 1925

192

S. J. LEWIS

Scout

K1 Map No. **KANSAS** Sec. *25* Twp. *03* R. *0E*

Well No. *9 Caldwell*

Waite Phillips Company

Contractor

SECTION PLAT

----- Ft. from N. Line

990 Ft. from S. Line

080 Ft. from E. Line

----- Ft. from W. Line

	o		

COMPLETED

Location -----

Rig up -----

Drilling and Remarks:

78.3245
Gas 3256
Oil 3260
711 3270 in sand
Shot 5-10-5-2096
Pump 62 ft

RECORD

Cased ----- in., ----- ft.

Sand -----

Gas -----

Oil -----

Total Depth -----

PRODUCTION

1st 24 hrs. Nat. -----

1st 24 hrs. after shot -----

Gas ----- Cu. Ft.

Dry Hole -----

Abandoned -----

Date

OCT 13 1925

S. J. LEWIS

Scout