


KANSAS

Russell

Section 7 Township 15 Range 13-W

Well No. #2 Krug

Company Royer & Farris

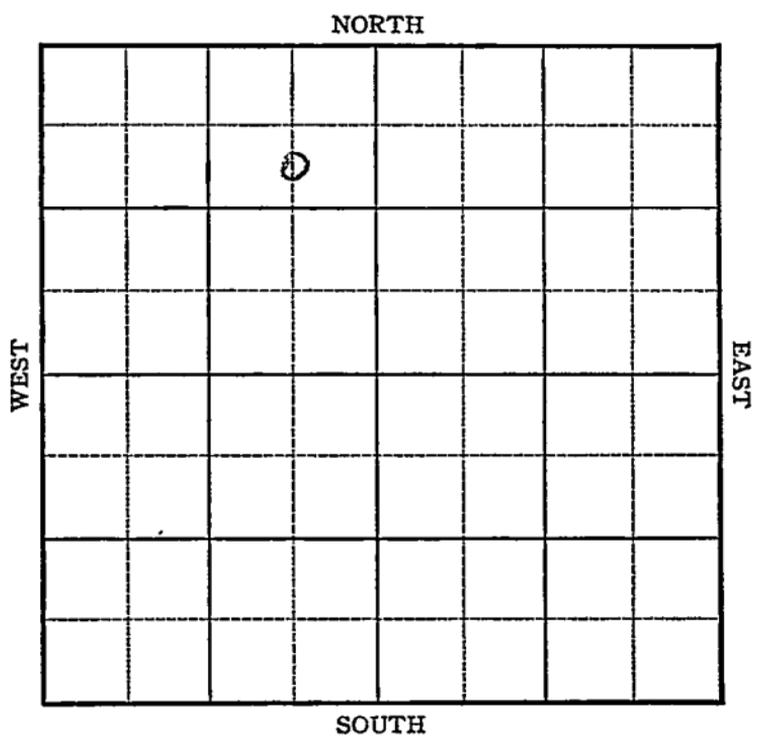

Sec. 7 Twp. 15 R. 13W

Well No. #2 Krug Farm

Royer and Farris Company


Trapp

990 Ft. from N. Line

_____ Ft. from S. Line

660 Ft. from E. Line

_____ Ft. from W. Line

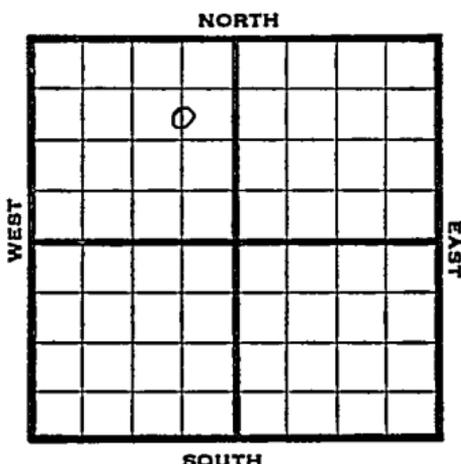

CSL NE NW

1946 Elev. 1840' REPORT

- 1/9 8" @ 299' WOC
- 1/17 Drlg. 2220'
- 1/24 Lens. 3034' Arb. 3314'
T.D. 3320' 5" - 3174' RUST.
- 1/31 Plug 3098' 58 shots 3053-65'
No shows.
- 2/7 50 shots 3045-52' 2500 acid.
300' oil & 25' water in 12 hours.
- 2/14 Plug 3020' 16 shots 2966-71'
3 gals oil per hour.
- 2/21 " " "
- 2/28 " " "
- 3/7 500 acid. 1/2 oil per hour.
- 3/14 " " "
- 3/21 " " "
- 3/28 " " "
- 4/4 " " "
- 4/10 " " "
- 4/16 " " "
- 4/20 " " "
- 5/1 Arb. 3314
Lens 3034
5" @ 3178
TD 3320'

ABANDONED

KANSAS Pool Name Trapp

Map No. 23 Sec. 7 Twp. 15 R. 13W

Well No. 2 Krug

Royer and Farris Company

~~FIRST REPORT~~ Contractor

C S L NE NW

SECTION PLAT

990 Ft. from N. Line

_____ Ft. from S. Line

660 Ft. from E. Line

_____ Ft. from W. Line

	c		

Russell County

Location _____

Rig up _____

Drilling and Remarks:
8"-299 WOC

RECORD

Cased _____ in., _____ ft.

Sand _____

Gas _____

Oil _____

Total Depth _____

PRODUCTION

1st 24 hrs. Nat. _____

1st 24 hrs. after shot _____

Gas _____ Cu. Ft.

Dry Hole _____

Abandoned _____

Date

JAN 9 1946 19

S. J. LEWIS Scout

KANSAS Kansas Pool Name Trapp

Map No. 23 Sec. 7 Twp. 15 R. 13W

Well No. 2 Krug

Royer and Farris Company

ABANDONED

Contractor

C S L NE NW

E 11840
SECTION PLAT

	o		

990 Ft. from N. Line

_____ Ft. from S. Line

660 Ft. from E. Line

_____ Ft. from W. Line

Russell County

Location _____

Rig up _____

Drilling and Remarks:

CR 43314

510317

Line 3084

RECORD

Cased _____ in., _____ ft.

Sand _____

Gas _____

Oil _____

Total Depth 3221

PRODUCTION

1st 24 hrs. Nat. _____

1st 24 hrs. after shot _____

Gas _____ Cu. Ft.

Dry Hole _____

Abandoned _____

Date

MAY 1 1946 19

S. J. LEWIS Scout