


KANSAS

Cowley

Section 23 Township 30 Range 3-E

Well No. #1 DeFore

Company Palmer Oil and Continental etal
(Wildcat)

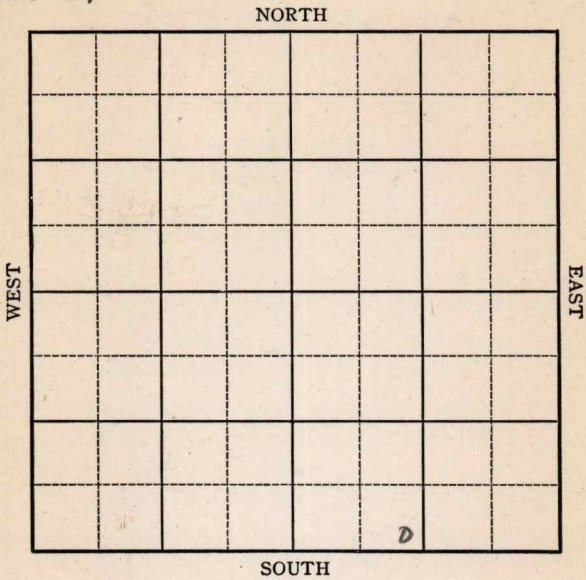

KANSAS

Cowley

Sec. 23 Twp. 30 R. 3-E

Well No. #1 De fore Farm
Palmer Oil and Continental et al
 (Wildcat) Company


Ft. from N. Line

330 Ft. from S. Line

Ft. from E. Line

990 Ft. from W. Line

Elev. 1239

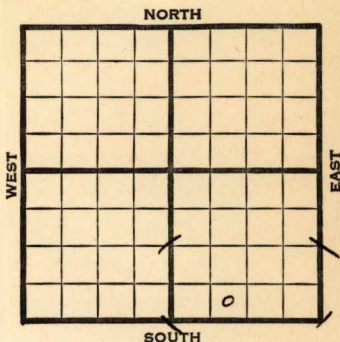

REPORT

1941

8/6	Cable.
-----	--------

8/15	Dlg. 100
------	----------

8/21 15" - 340' Drlg. 1000'

8/28	13" - 1105'	10" - 1839'
------	-------------	-------------

Drlg. 1880'

9/4 8" - 2315' K.C. 2435'

Drlg. 2630'

9/11 Miss. 3013' Drlg. 3060'

9/17 Arb. 3405'

T. D. 3415'

H.F.W.

ABANDONED

KANSAS

Cowley

Map No. 12 Sec. 23 Twp. 30 R. 3EWell No. 1 Defore
Palmer Oil and Continental et al
Company

FIRST REPORT

Contractor

SE SW SE

Ft. from N. Line


330 Ft. from S. Line

Ft. from E. Line

990 Ft. from W. Line

WILDCAT

SECTION PLAT

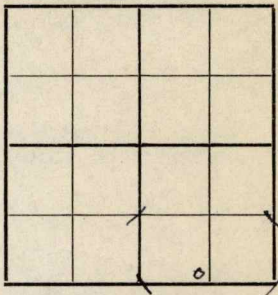

Location _____

Rig up _____

Drilling and Remarks:

Cable

RECORD

Cased _____ in., _____ ft.

Sand _____

Gas _____

Oil _____

Total Depth _____

PRODUCTION

1st 24 hrs. Nat. _____

1st 24 hrs. after shot _____

Gas _____ Cu. Ft.

Dry Hole _____

Abandoned _____

Date

AUG 6 1941

19

S. J. LEWIS

Scout

Map No. 12 Sec. 23 Twp. 30 R. 3EWell No. 1 DeforePalmer Oil and Continental Company**ABANDONED**

Contractor

SE SW SE

SECTION PLAT

			0

 Ft. from N. Line330 Ft. from S. Line Ft. from E. Line990 Ft. from W. Line

WILDCAT

Location Rig up

Drilling and Remarks:

*Ce 83405**HFW.***RECORD**Cased in., ft.Sand Gas Oil Total Depth 3415**PRODUCTION**1st 24 hrs. Nat. 1st 24 hrs. after shot Gas Cu. Ft.Dry Hole Abandoned

Date

SEP 17 1941

19

S. J. LEWIS

Scout