

KANSAS


Russell

Section 7 Township 15 Range 13W

Well No. 2 Krug

Company Derby Oil et al

Trapp

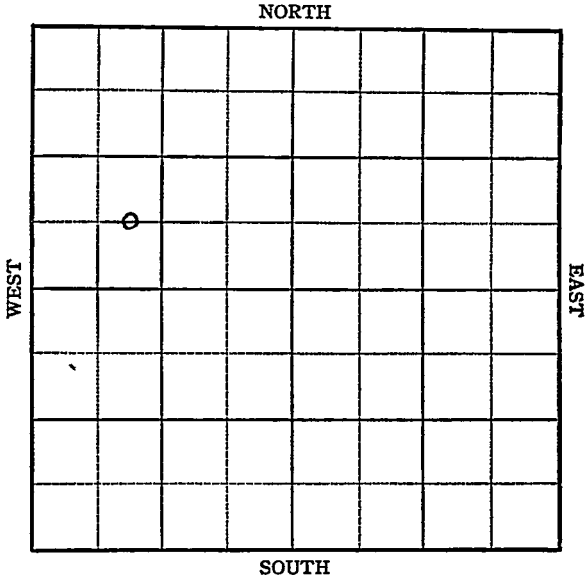

Sec. 7 Twp. 15 R. 13W ✓

Well No. #2 Krug Farm

Derby Oil et al Company

Trapp Pool


 Ft. from N. Line

660' Ft. from S. Line

 Ft. from E. Line

990' Ft. from W. Line

C E L SW NW

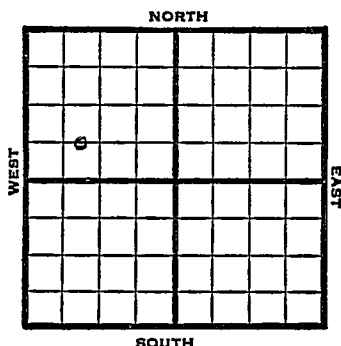

1949

^E lev 1859' REPORT

3/30 8" @ 453'
Drlg. 600'

4/6 Lansing 3040'
Arb. 3307-10'
TD 3310'
4"@ 3307'

4/12 500 acid
Swb 2 3/4 bbls oil 16 hrs.

4/20 "

4/27 "

5/4 "

5/11 TD 3310'
Arb. 3307'
4"@ 3307'
500 acid
Pump 55 Oil Pot
40⁹ Gr.
omp

COMPLETED

Map No. _____ Sec. 7 Twp. 15 R. 13W

Well No. 2 Krug

Derby Oil etal. Company

FIRST REPORT Contractor

C E L SW NW

SECTION PLAT

_____ Ft. from N. Line

660 Ft. from S. Line

_____ Ft. from E. Line

990 Ft. from W. Line

Russell County

RECORD

Location _____

Cased _____ in., _____ ft.

Rig up _____

Sand _____

Drilling and Remarks: _____

Gas _____

Oil _____

Total Depth _____

8" @ 453

drlg. 600

PRODUCTION

1st 24 hrs. Nat: _____

1st 24 hrs. after shot _____

Gas _____ Cu. Ft.

Dry Hole _____

Abandoned _____

Date

MAR 30 1949

Kansas

Map No. K73 Sec. 7 Twp. 15 R. 13W

Well No. 2 Krug

Derby Oil etal. Company

COMPLETE

Contractor

C E L S W N W

E11859
SECTION PLAT

o			

 Ft. from N. Line

660 Ft. from S. Line

 Ft. from E. Line

990 Ft. from W. Line

Russell County

Location

Rig up

Drilling and Remarks:

Per 3307

4" @ 3307

500 rods

Imp Oil Prod

40 I h

RECORD

Cased in., ft.

Sand

Gas

Oil

Total Depth 3310

PRODUCTION

1st 24 hrs. Nat.

1st 24 hrs. after shot

Gas Cu. Ft.

Dry Hole

Abandoned

Date

MAY 11 1949 19

S. J. LEWIS Scout