

KANSAS


Form 51-5M-7-39-Palace

Russell

Section 7 Township 15 Range 13-W

Well No. #5 Josephine

Company Carter Oil Coralena Pool

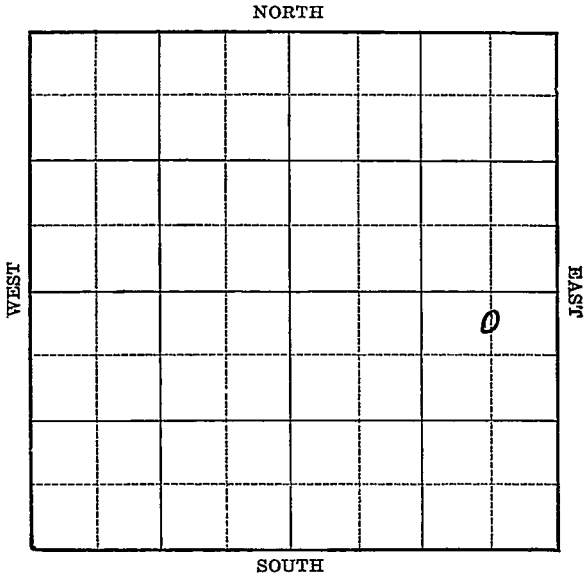

Sec. 7 Twp. 15 R. 13-W

Well No. #5 Josephine Farm

Carter Oil Company

(Coralena)


330 Ft. from N. Line

 Ft. from S. Line

660 Ft. from E. Line

 Ft. from W. Line

Elev. 1802

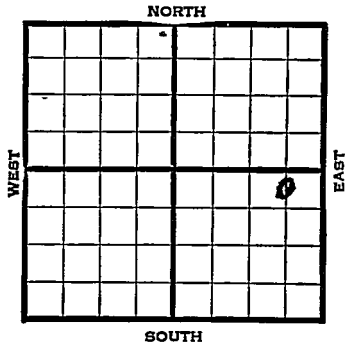

1940	REPORT
5/8	Location
5/16	"
5/23	"
5/29	"
6/6	"
6/13	"
6/20	"
6/27	8" - 263' Drlg. 938'
7/3	Drlg. 2610'
7/11	Topeka 2620' Dodge 2938'
	Lans. 2968' S.O. 2997-3000 &
	3011' Arb. 3256-59' T.D.
	5" - 3256' RUST.
7/18	" " "
7/25	7000 acid. Swab 20 bbls. per hour, 11 hours.
8/2	Pump 40 oil 6 hours, no water.
	OVER

1940
8/7

Arb. 3256'
Lans. 2968'
5" - 3256'
T.D. 3259'
Ripped csg. 2995-3023'
7300 acid.
Potential 255 bbls., pump.

COMPLETED

Map No. 73 Sec. 7 Twp. 15 R. 13WWell No. 5 JosephineCarter Oil Company

Contractor

FIRST REPORT
C N L N E S E330 Ft. from N. Line Ft. from S. Line660 Ft. from E. Line Ft. from W. Line**CORALENA POOL****SECTION PLAT**

			o

Location XRig up

Drilling and Remarks:

RECORDCased in., ft.Sand Gas Oil Total Depth ft.**PRODUCTION**1st 24 hrs. Nat. 1st 24 hrs. after shot Gas Cu. Ft.Dry Hole Abandoned

Date

MAY 8 1940 19 S. J. LEWIS Scout

Map No. 73 Sec. 7 Twp. 15 R. 13W

Well No. 5 Josephine

Carter Oil Company

Contractor

COMPLETED

SECTION PLAT

330 **C N L NE SE**
Ft. from N. Line

_____ Ft. from S. Line

660 Ft. from E. Line

_____ Ft. from W. Line

			o

CORALENA POOL

Location _____

Rig up _____

Drilling and Remarks:

*Cu & 3256. Line 2967
5" @ 3256*

*Ry. 106 cog. 2995-
3023*

7800 acid

Pump 255 P.S.

RECORD

Cased _____ in., _____ ft.

Sand _____

Gas _____

Oil _____

Total Depth 3257

PRODUCTION

1st 24 hrs. Nat. _____

1st 24 hrs. after shot _____

Gas _____ Cu. Ft.

Dry Hole _____

Abandoned _____

Date

AUG 7 1940 19

S. J. LEWIS Scout