


Section 7 Township 15 Range 13 W

Well No. # 9 Krug

Company Derby Oil

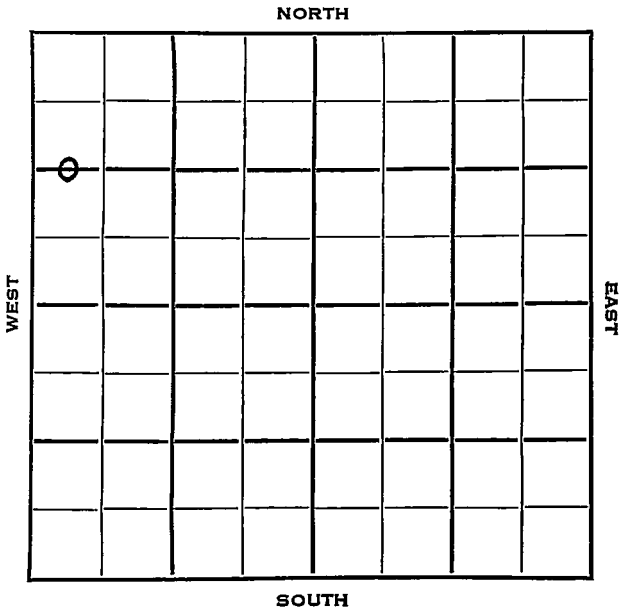

Russell KANSAS ✓

Sec. 7 Twp. 15 R. 13W

Well No. #9 Krug Farm

Derby Oil Company

Peel Bros. Contractor


1320 Ft. from N. Line

_____ Ft. from S. Line

_____ Ft. from E. Line

330 Ft. from W. Line

C $W\frac{1}{2}$ $W\frac{1}{2}$ NW

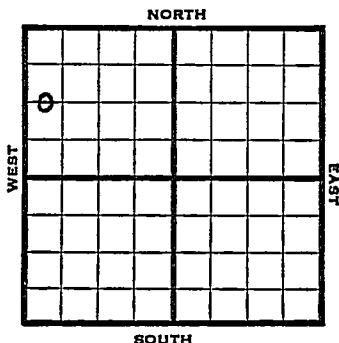

1953

Elev. 1861'

REPORT

5/13

Location

5/21

Moving in

6/3

SWD

6/17

Spud 5-21-53

SWD Well

TD 3637'

8" @ 488'

Heeb 2981, Lans 3049,

DST 3082-89 opn $\frac{1}{2}$ hr, rec 5' mud,

Arb 3327, Gr. Wash 3593

TD 3637'

5" @ 3390'

GO to 3637'

5000 A

Comp. for SWD Well.

ABANDONED

County Russell State Kansas

Sec. 7 (Blk. Twp.) 15 (Sur. Rge.) 13W Map No.

Operator Derby Oil

Well No. 9 Farm Krug

Elev. _____ Location C W $\frac{1}{2}$ W $\frac{1}{2}$ NW

1320 Ft. From N Line NW

530 Ft. From W Line Quarter

1st. Report MAY 13 1953

Completion _____

Remarks _____

Peel Bros. - Contr.

Spudding Date _____

Drig. Data _____

Location

