


Russell C.

Map No. Kan Sec. 8 Twp. 12 R. 15^W

Well No. 2 Oswald Farm

Streeter & Stearns Company

NORTH

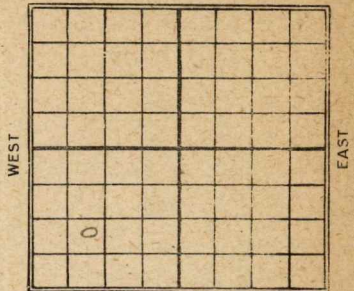

_____ Ft. from N. Line

1120 Ft. from S. Line

_____ Ft. from E. Line

1120 Ft. from W. Line

Date

REPORT

1924

11/23 Slg 1750'

1925

1/21 Lime Pay 2938. T.D. 2963
Pumping 250 Bbls

Russell Co.

Map No. **KANSAS** Sec. 8 Twp. 12 R. 15W

Well No. 205 Wald

Streeter & Stearns Company

Contractor

FIRST REPORT

SECTION PLAT

----- Ft. from N. Line

1120' Ft. from S. Line

----- Ft. from E. Line

1120' Ft. from W. Line

Location -----

Rig up -----

Drilling and Remarks:

D. 1750'

RECORD

Cased ----- in., ----- ft.

Sand -----

Gas -----

Oil -----

Total Depth -----

PRODUCTION

1st 24 hrs. Nat. -----

1st 24 hrs. after shot -----

Gas ----- Cu. Ft.

Dry Hole -----

Abandoned -----

Date

NOV 23 1924

M. A. BENEAR

----- 192 -----

----- Scout

KANSAS

Map No. 8 Sec. 8 Twp. 12 R. 15W

Well No. 2 Oswald

Street & Stearns Company

Contractor

COMPLETED

SECTION PLAT

0			

----- Ft. from N. Line

1120 Ft. from S. Line

----- Ft. from E. Line

1120 Ft. from W. Line

Location -----

Rig up -----

Drilling and Remarks:

*Line Pay 2938-
2963 F.O.
pumping 250 &*

RECORD

Cased ----- in., ----- ft.

Sand -----

Gas -----

Oil -----

Total Depth -----

PRODUCTION

1st 24 hrs. Nat. -----

1st 24 hrs. after shot -----

Gas ----- Cu. Ft.

Dry Hole -----

Abandoned -----

Date

1/21

1925

M. A. BENEAR

Scout