


Section 9 Township 15 Range 13-W

Well Number 1--M.Rosener

Company Stanolind

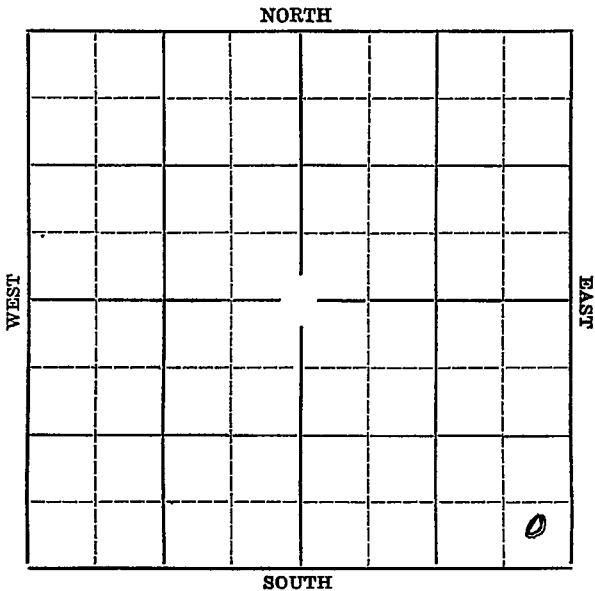

Map No. KANSAS Sec. 9 Twp. 15 R. 13-W

Well No. 1 M. Rosener Farm  
Stanolind Company


         Ft. from N. Line

330 Ft. from S. Line

330 Ft. from E. Line

         Ft. from W. Line

Elev. 1868

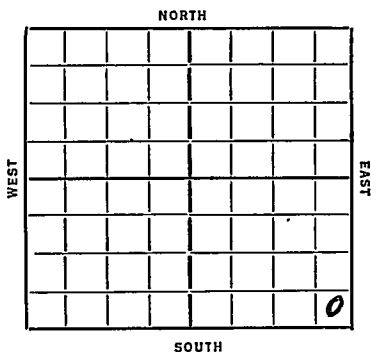

Date	REPORT
1936	
4/22	Location
4/30	--
5/7	Rig.
5/14	Drlg. 300'.
5/21	Drlg. 1750'.
5/28	Drlg. 2725'.
6/4	Lansing 3041'. 7" @ 3071'. S.O. 3057-59'.
6/11	Rigging up standard tools.
6/18	Drlg. 3231'.
6/25	Sil. 3315' to 20'. RUST.
7/2	Oil 3336-38'. T.D. 3340' swab 15 bbls of oil per hour. 2,000 gallons of acid. No test.
7/9	--
7/15	36-Sil. 3315'.
	Pay 3336-38'. <b>COMPLETED</b>
	2000 gallons of acid.
	T.D. 3340'.
	500 bbls of oil 20% water pot. <b>COMPLETED</b>

Map No. 73 Sec. 9 Twp. 15 R. 13 N

Well No. 1 M. Rosemer

Standard Company

Contractor

SECTION PLAT

..... Ft. from N. Line

330 Ft. from S. Line

330 Ft. from E. Line

..... Ft. from W. Line

			0

FIRST REPORT

Location ✓

Rig up

Drilling and Remarks:

RECORD

Cased.....in., .....ft.

Sand.....

Gas.....

Oil.....

Total Depth.....

PRODUCTION

1st 24 hrs. Nat.....

1st 24 hrs. after shot.....

Gas..... Cu. Ft.

Dry Hole.....

Abandoned.....

Date

APR 2 192.....

S. J. LEWIS Scout

Map No. 73 Sec. 9 Twp. 15 R. 13WWell No. 1 M. RosnerStandard Company

Contractor

## SECTION PLAT

			0

\_\_\_\_\_ Ft. from N. Line

330 Ft. from S. Line330 Ft. from E. Line

\_\_\_\_\_ Ft. from W. Line

COMPLETED

Location \_\_\_\_\_

Rig up \_\_\_\_\_

Drilling and Remarks:

Sil 3315  
Pay 3336-38  
2000 acid  
Pay 500 1/2 hr.  
20% Water

## RECORD

Cased \_\_\_\_\_ in., \_\_\_\_\_ ft.

Sand \_\_\_\_\_

Gas \_\_\_\_\_

Oil \_\_\_\_\_

Total Depth. 3340

## PRODUCTION

1st 24 hrs. Nat. \_\_\_\_\_

1st 24 hrs. after shot \_\_\_\_\_

Gas \_\_\_\_\_ Cu. Ft.

Dry Hole \_\_\_\_\_

Abandoned \_\_\_\_\_

Date

JUL 15 1936S. J. LEWIS Scout