

Section 7 Township 15 Range 13W

Well No. #4 Krug

Company Derby Oil

NORTH

		0					

WEST

EAST

SOUTH

Sec. 7 Twp. 15 R. 13 W

Well No. # 4 Krug Farm

Derby Oil Company

Peel Contractor

Trapp


330 Ft. from N. Line

Ft. from S. Line

990 Ft. from E. Line

Ft. from W. Line

NW NE NW

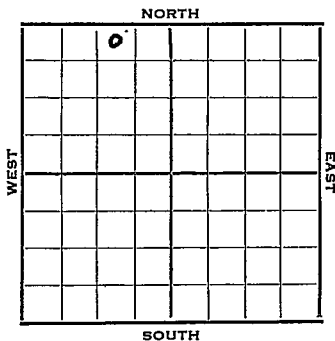

1952

Elev. 1811'

REPORT

- 4/2 Location
- 4/9 "
- 4/23 8" @ 152' Heeb 2905' Lans. 2971'  
DST 3003-20, 1/2 hr, 860' gas,  
100' VHO & GCM, 685# FP 50#  
DST 3066-80', 1 hr, 135' OCM & SW  
350#  
Drlg. 3160'
- 4/30 DST 3160-70' 1 hr. 180 HO&GCM  
1000# Arb. 3242-50 RTD  
5" @ 3245' CO to TD S/23 BOPH POP
- 5/7 ~~NW~~
- 5/14 "
- 5/21 "
- 5/28 "
- 6/11 Spud 4-14-52  
Oil well TD 3250' 8" @ 152  
Heeb 2905' Lans. 2971'  
DST 3003-20 open 1/2 hr. rec 860' gas  
100' VHO & GCM  
DST 3066-80 open 1 hr. rec 135' OCM &  
SW  
DST 3160-70 open 1 hr. rec 180' HO &  
GCM. Arb. 3242' 5" @ 3245'  
TD 3250' S/23 BOPH  
Comp. 168 BOPD

COMPLETED



County Russell State Kansas  
 Sec. 7 (Blk. 15 (Sur. 13W Map No.  
 (Twp.) (Rge.)  
 Operator Derby Oil  
 Well No. 4 Farm Krug  
 Elev. 1811 Location NW NE NW

		0			

330 Ft. From N Line NW  
990 Ft. From E Line Quarter  
 Ist. Report \_\_\_\_\_  
 Completion JUN 11 1952  
 Remarks Trapp Pool  
Peel - Contr.  
 Spudding Date 4-14-52

Drlg. Data Oil well TD 3250  
8" @ 152 Heeb. 2905 Lans. 2971  
DST 3003-20 open  $\frac{1}{2}$  hr. Rec. 860' gas  
100' vho & gcm DST 3066-80 open 1 hr.  
Rec. 135' ocm & sw DST 3160-70  
open 1 hr. Rec. 180' ho & gcm Arb. 3242  
5" @ 3245 TD 3250 S/ 23 boph  
Comp. 168 bopd