


Section 7 Township 15 Range 13W

Well No. #3 Krug

Company Derby Oil

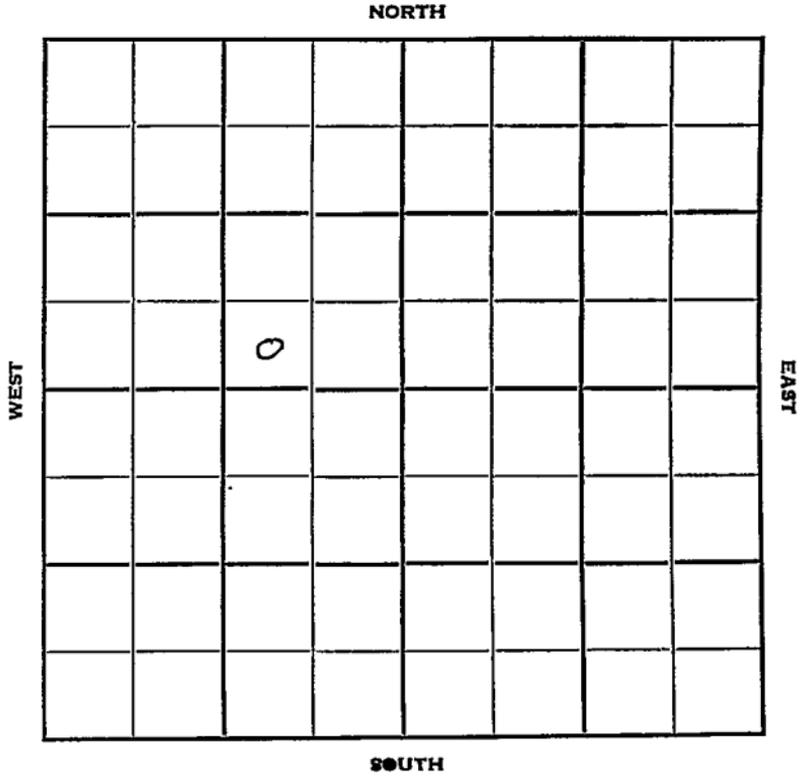

Sec. 7 Twp. 15 R. 13W

Well No. #3 Krug Farm

Derby Oil Company

Contractor

Trapp Pool


_____ Ft. from N. Line

330' Ft. from S. Line

990' Ft. from E. Line

_____ Ft. from W. Line

SW SE NW

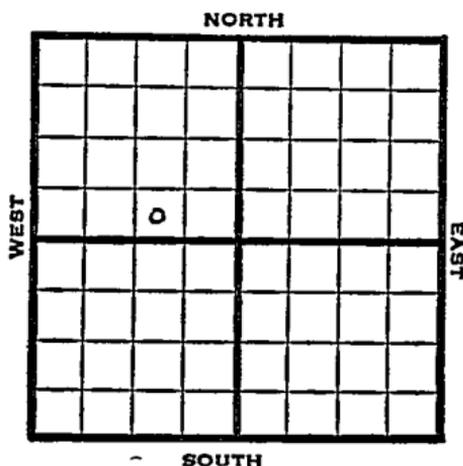

1950

Elev. 1858' REPORT

11/22

Location

1951

1/17

Spud 12-18-50
 Oil Well TD 3307'
 8" @ 469' Lans. 3040
 DST 3072-84 opn 1/2 hr Rec. 20' mud
 Cong. 3302 Arb. 3304
 TD 3306 5 1/2" @ 3305
 S/1 boph DD 3307 500 A S/45 boph
 FU 2800' oil 8 hr Comp. 157 bopd

COMPLETED

