

KANSAS


Russell

FORM 51 5M PETROL

Section 7 Township 15 Range 13W

Well No. 1 Krug

Company Royer & Farris

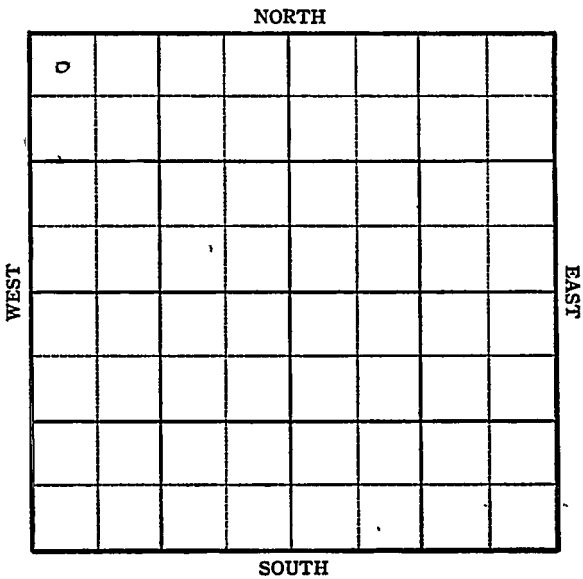

KANSAS

Sec. 7 Twp. 15 R. 13WWell No. #1 Krug FarmRoyer & Farris Company

Trapp


330 Ft. from N. Line

Ft. from S. Line

Ft. from E. Line

330 Ft. from W. Line

NW/c

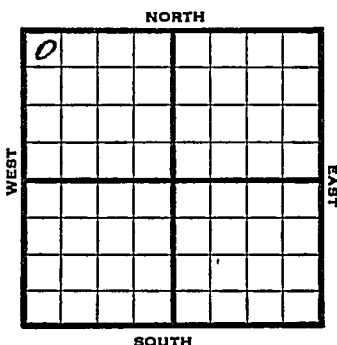

1945

Elev. 1840

REPORT

10/31 Drilg. 400'

11/7 Anhy 825

8" @ 145

Drilg. 2135

11/14 Lans 3026

Drilg. 3212'

11/21 Arb. 3335-3342

TD 3342

5" @ 3151' RUST

11/28 PB 3082

58 shots 3058-3066 500 acid.

300' oil plus 100' Wtr. in 14 hrs.

12/5 5000 acid.

Swb. 10 oil per hr. plus 20% wtr. for 7 hrs.

12/12 Pump 96 oil in 16 hrs.

12/20 5000 acid. Swab 10 oil per hour plus 20% water for 7 hours.

12/29 " " "

1946 " " "

1/10 " " "

1/17 " " "

OVER

1946

1/23

Lans 3026

Arb. 3335

5" @ 3151

Perf. Lans. 1000 acid.

TD 3342'

Pump 26 oil plus 55% wtr. Pot.

Grav. 40

COMPLETED

Kansas Pool Name Trapp

KANSAS

Map No. 73 Sec. 7 Twp. 15 R. 13WWell No. 1 KrugRoyer & Farris

Company

FIRST REPORT

Contractor

NW/c

SECTION PLAT

330


Ft. from N. Line

Ft. from S. Line

Ft. from E. Line

330

Ft. from W. Line

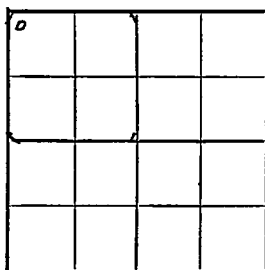

Russell County

Location

Rig up

Drilling and Remarks:

400'

RECORD

Cased _____ in., _____ ft.

Sand _____

Gas _____

Oil _____

Total Depth _____

PRODUCTION

1st 24 hrs. Nat. _____

1st 24 hrs. after shot _____

Gas _____ Cu. Ft.

Dry Hole _____

Abandoned _____

Date

OCT 31 1945

19

S. J. LEWIS Scout

KANSAS Kansas Pool Name Trapp

Map No. 23 Sec. 7 Twp. 15 R. 13W

Well No. 1 Krug

Royer and Farris

Company

COMPLETED

Contractor

NW/c

E1, 1840
SECTION PLAT

330 Ft. from N. Line

_____ Ft. from S. Line

_____ Ft. from E. Line

330 Ft. from W. Line

0			

Russell County

Location _____

Rig up _____

Drilling and Remarks:

lane 3026

Ar 3335

5" C 3151

Perf lane.

16000 oil

Pump 26 oil 755%

Water R. J.

45 Hr.

Date

RECORD

Cased _____ in., _____ ft.

Sand _____

Gas _____

Oil _____

Total Depth 3342

PRODUCTION

1st 24 hrs. Nat. _____

1st 24 hrs. after shot _____

Gas _____ Cu. Ft.

Dry Hole _____

Abandoned _____

JAN 23 1946

19

S. J. LEWIS

Scout