

Russell County

Trapp Pool

FORM 51 IOM 12-46 PETROL


KANSAS

Section 7 Township 15 Range 13W

Well No. 1 Krug

Company Derby etal.

NORTH

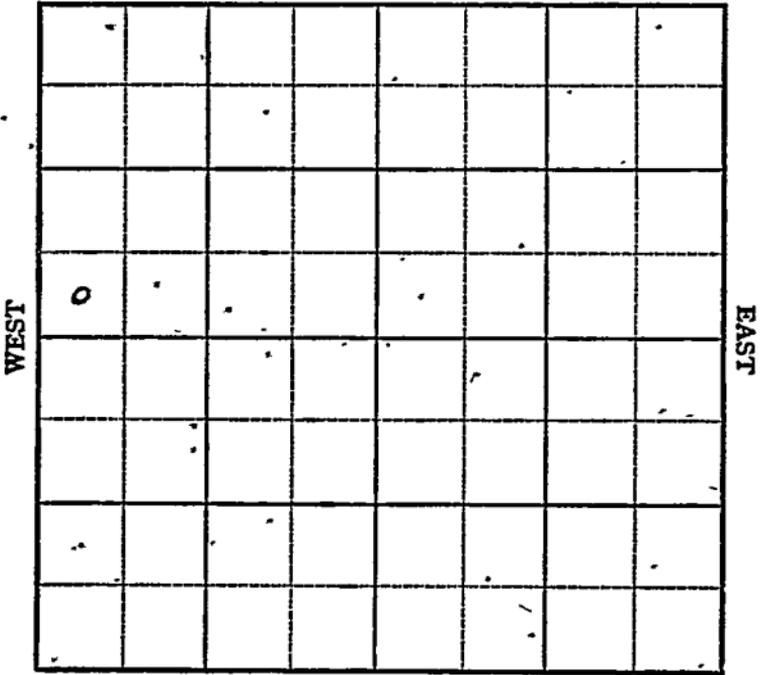

SOUTH

Sec. 7 Twp. 15 R. 13-W

Well No. #1 Krug Farm

Derby etal Company
Trapp Pool


Ft. from N. Line

330 Ft. from S. Line

Ft. from E. Line

330 Ft. from W. Line

SW NW Elev. 1872'

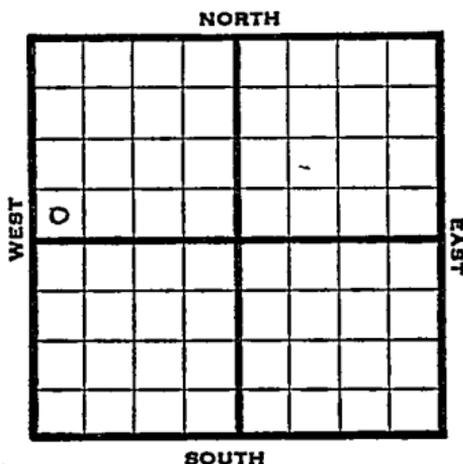

REPORT

1947


- 2/26 Location
- 3/4 Surface hole
- 3/11 Drlg 454'
- 3/18 Lans 3050
Arb 3315
TD 3317'
5" @ 3316'
RUST
- 3/25 TD 3320'
500 Acid
Swab $3\frac{1}{2}$ oil PH 10 hrs
- 4/2 " " "
- 4/9 " " "
- 4/15 " " "
- 4/23 Arb 3315
5" @ 3316
500 Acid
Pump 132 Pot
Grav. 40.9
TD 3320'

COMPLETED

Kansas **KANSAS** Trapp PoolMap No. 73 Sec. 7 Twp. 15 R. 13WWell No. 1 KrugDerby etal. Company**FIRST REPORT** Contractor

SW NW

SECTION PLAT

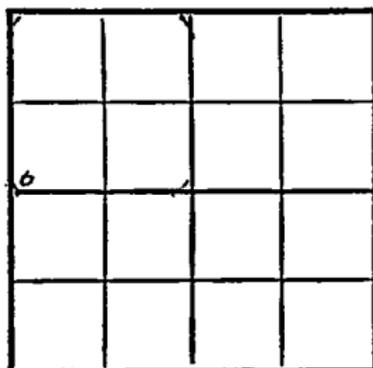 Ft. from N. Line330 Ft. from S. Line Ft. from E. Line330 Ft. from W. LineRussell CountyLocation XRig up

Drilling and Remarks:

RECORD

Cased in., ft.Sand Gas Oil Total Depth

PRODUCTION

1st 24 hrs. Nat. 1st 24 hrs. after shot Gas Cu. Ft.Dry Hole Abandoned

Date

FEB 26 1947 19S. J. LEWIS Scout

