

Russell


KANSAS

FORM 51 5M 2-38 TPCO.

Section 7 Township 15 Range 13-W

Well No. 1 Krug

Company Yahey & Stearns

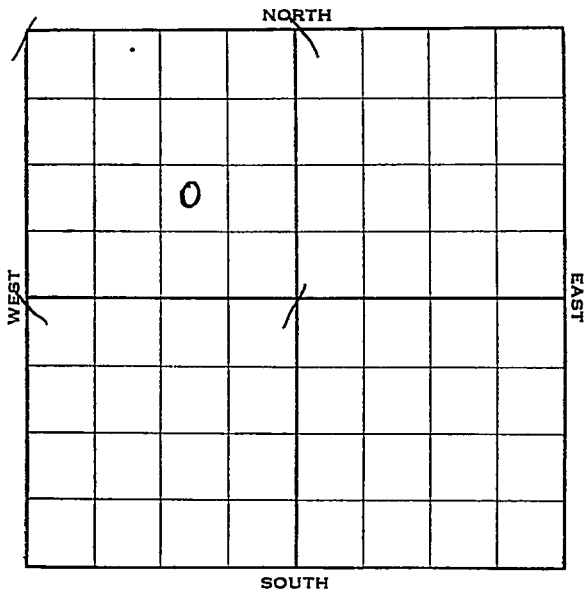

1938

- 12/2 5" - 3317'. 2700' oil.
Swab 5 oil per hour 15 hrs.
S.S.W. Deepened to 3329'.
- 12/9 T. D. 3329'. 2 bbls. fluid
per hr. 60% water.
Will P. B.
- 12/15 P. B. 3244'. C. O.
- 12/23 5000 acid 3228-38'.
4000 acid 3182-84'.
4000 acid 3136-38'.
- 12/30 Pump 25 oil per hr. for 4 hrs.
Water broke in. Recement.

1939

- 1/4 Lans. 3030'.
Arb. 3310'.
T. D. 3329'.
P. B. 3244'.
5000 acid. 3228'-38'.
4000 acid 3182-84'.
4000 acid 3136-38'.
Potential 795 bbls.
Est. 3 to 6% water.

COMPLETED

Map No. 73 Sec. 7 Twp. 15 R. 13W

Well No. 1 Krug

Yankey & Stearns Company

Contractor

COMPLETED

NW SE NW

_____ Ft. from N. Line

990 Ft. from S. Line

990 Ft. from E. Line

_____ Ft. from W. Line

Coralena
~~WILDCAT~~

SECTION PLAT

	0		

Location _____

Rig up _____

Drilling and Remarks:

P.B. 3244
5000 Acid 3228-38
4000 3182-84
4000 3136-38
POT 795
EST 3 To 6 70 wtr

RECORD

Cased _____ in., _____ ft.
Sand *LANS 5030*
ARB 3310
Gas _____
Oil _____
Total Depth *5329*

PRODUCTION

1st 24-hrs. Nat. _____
1st 24 hrs. after shot _____
Gas _____ Cu. Ft.
Dry Hole _____
Abandoned _____

Date

JAN 4 - 1939 19

H. D. Hatfield Scout