

KANSAS


FORM 51 5M 4-41 PETROL

Russell

Section 7 Township 15 Range 13W

Well No. 6 Josephine (Twin #1)
50' East

Company Garter Oil

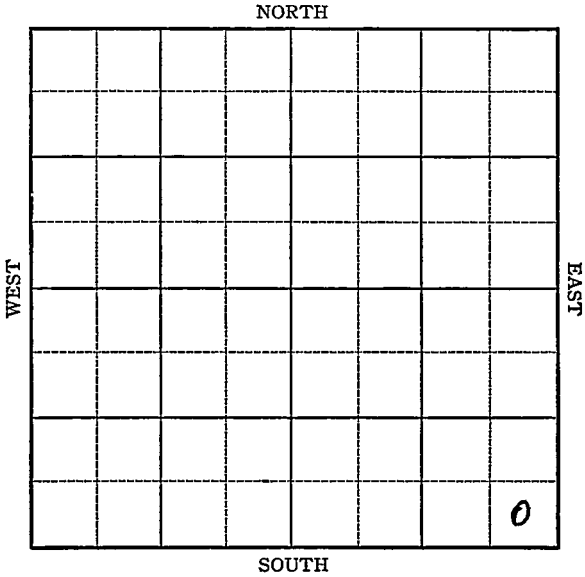

Map No. _____ Sec. 7 Twp. 15 R. 13W

Well No. 6 Josephine (Twin #1)

50' East

Carter Oil Company

Contractor

FIRST REPORT

SE/C

_____ Ft. from N. Line

330 Ft. from S. Line

280 Ft. from E. Line

_____ Ft. from W. Line

SECTION PLAT

			o

TRAPP POOL

Location X

Rig up _____

Drilling and Remarks:

RECORD

Cased _____ in., _____ ft.

Sand _____

Gas _____

Oil _____

Total Depth _____

PRODUCTION

1st 24 hrs. Nat. _____

1st 24 hrs. after shot _____

Gas " _____ Cu. Ft.

Dry Hole _____

Abandoned _____

Date
JUN 4 1941

Map No. 73 Sec. 7 Twp. 15 R. 13W

Well No. 6 Josephine (Twin #1)

Carter Oil Company

COMPLETED Contractor

SE/C

_____ Ft. from N. Line

330 Ft. from S. Line

280 Ft. from E. Line

_____ Ft. from W. Line

SECTION PLAT

			o

TRAPP POOL

Location _____

Rig up _____

Drilling and Remarks:

Lans 2927
5" @ 2933
500 acid
Pump 299 Pt

89-Gr

RECORD

Cased _____ in., _____ ft.

Sand _____

Gas _____

Oil _____

Total Depth 2974

PRODUCTION

1st 24 hrs. Nat. _____

1st 24 hrs. after shot _____

Gas _____ Cu. Ft.

Dry Hole _____

Abandoned _____

Date

JUL 16 1941₁₉

S. J. LEWIS Scout