


Section.....7.....Township.....15.....Range.....13-W

Well Number.....3 - Josephine.....


Company.....Carter.....

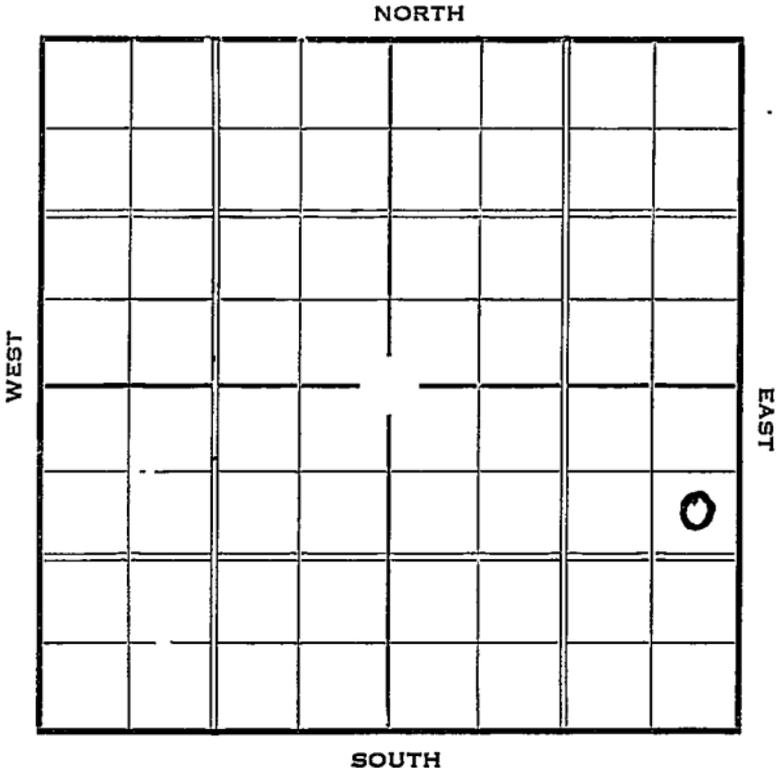

Sec. 7 Twp. 15 R. 13-W

Well No. #3 Josephine Farm
Carter Company

990 Ft. from N. Line
 _____ Ft. from S. Line
330 Ft. from E. Line
 _____ Ft. from W. Line
 Elev. 1780

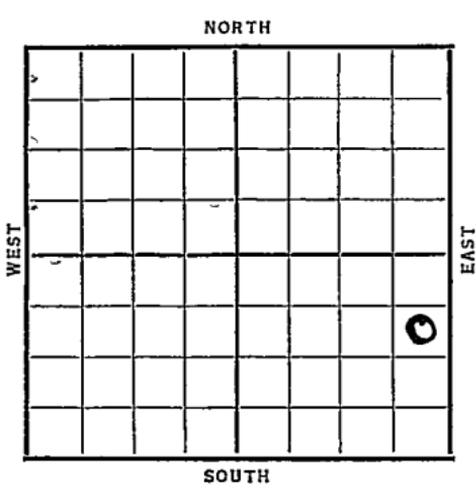

Date	REPORT
1937	
6/23	Mov. in Mat.
7/2	R U R
7/9	10" @ 413'. WOC.
7/16	SD 1840'.
7/23	Set Whipstock @ 1750'.
	Drlg. 2428'.
7/30	S.O. 2895-2913'.
	Coring 3218'.
8/6	Sil. & 6" @ 3226'. T.D. 3231'.
	Sat. core.
8/13	2900' oil 3 hrs. 1500 acid.
	Testing.
	OVER

1937

8/18 6" @ 3226'.

Sil. 3226'.

T.D. 3231'.

1500 acid.

Pump 291 bbls. 4 hrs.

284 bbls. 4 hrs.

Pot. 1704 bbls.

COMPLETED

Russell KANSAS

Map No. 73 Sec. 7 Twp. 15 R. 13^W

Well No. 3 - Josephine
Carter Company

Contractor

FIRST REPORT

SECTION PLAT

940 Ft. from N. Line

_____ Ft. from S. Line

330 Ft. from E. Line

_____ Ft. from W. Line

			0

Location _____

Rig up _____

RECORD

Cased _____ in., _____ ft.

Sand _____

Drilling and Remarks:

Gas _____

Oil _____

mov. in mat.

Total Depth _____

PRODUCTION

1st 24 hrs. Nat. _____

1st 24 hrs. after shot _____

Gas _____ Cu. Ft.

Dry Hole _____

Abandoned _____

Date

JUN 23 1937

19

H. D. Hatfield Scout

Russell **KANSAS**Map No. _____ Sec. 7 Twp. 15 R. 13^wWell No. 3 - JosephineCarter Company

Contractor

COMPLETED990 Ft. from N. Line

_____ Ft. from S. Line

330 Ft. from E. Line

_____ Ft. from W. Line

SECTION PLAT

			0

Location _____

Rig up _____

Drilling and Remarks:

1500 AcidP. - 291/4284/4Pot - 1704**RECORD**Cased 6 in., 3226 ft.Sand 511 3226

Gas _____

Oil _____

Total Depth 3231'**PRODUCTION**

1st 24-hrs. Nat. _____

1st 24-hrs. after shot _____

Gas _____ Cu. Ft.

Dry Hole _____

Abandoned _____

Date

AUG 18 1937 19H. D. Hatfield Scout