
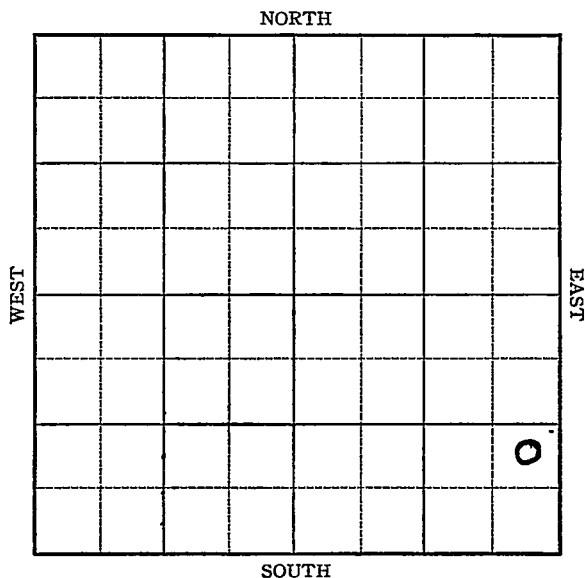


Section 7 Township 15 Range 13-WWell No. 2 - JosephineCompany Carter

Sec. 7 Twp. 15 R. 13-WWell No. #2 Josephine FarmCarter Company Ft. from N. Line990 Ft. from S. Line330 Ft. from E. Line Ft. from W. Line

Elev. 1776

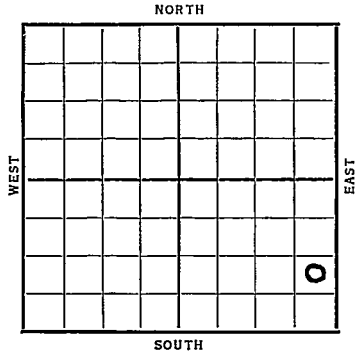

Date	REPORT
1937	
5/26	Rig'n Rot.
6/4	12" @ 341'. WOC.
6/11	Drlg. 2225'.
6/19	Topeka 2627'. K.C. 2940'.
	T.D. 2995' S.O.
6/25	Sil. 3210'. Sat Core.
	7" @ 3212'. T.D. 3213'.
	RUST.
7/2	T.D. 3216'. 2000' oil.
	1500 acid. Pump 934 bbls.
	12 hrs.
7/7	7" @ 3212'.
	Sil. 3210'.
	T.D. 3216'.
	1500 A
	Pot. 2342 bbls.
	COMPLETED

Russell KANSAS

Map No. _____ Sec. 7 Twp. 15 R. 13 ^WWell No. 2-JosephineCarter

Company

Contractor

FIRST REPORT

SECTION PLAT

			0

_____ Ft. from N. Line

990 Ft. from S. Line330 Ft. from E. Line

_____ Ft. from W. Line

Location _____

Rig up _____

Drilling and Remarks:

Rigin Rot.

RECORD

Cased _____ in., _____ ft.

Sand _____

Gas _____

Oil _____

Total Depth _____

PRODUCTION

1st 24 hrs. Nat. _____

1st 24 hrs. after shot _____

Gas _____ Cu. Ft.

Dry Hole _____

Abandoned _____

Date

MAY 26 1937

19

H. D. Hatfield

Scout

Russell KANSAS

Map No. _____ Sec. 7 Twp. 15 R. 13^WWell No. 2 - JosephineCarter Company

Contractor _____

COMPLETED

_____ Ft. from N. Line

990 Ft. from S. Line330 Ft. from E. Line

_____ Ft. from W. Line

SECTION PLAT

			0

Location _____

Rig up _____

Drilling and Remarks:

1500 APort 2342

RECORD

Cased 7 in., 3212 ft.Sand 511 3210

Gas _____

Oil _____

Total Depth 3216

PRODUCTION :

1st 24 hrs. Nat. _____

1st 24 hrs. after shot _____

Gas _____ Cu. Ft.

Dry Hole _____

Abandoned _____

Date

JUL 7 1937H. D. Hatfield19

Scout