

KANSAS


Russell

FORM 51 5M PETROL

Section 6 Township 15 Range 13 W

Well No. #1 Peck

Company W.M. Peck

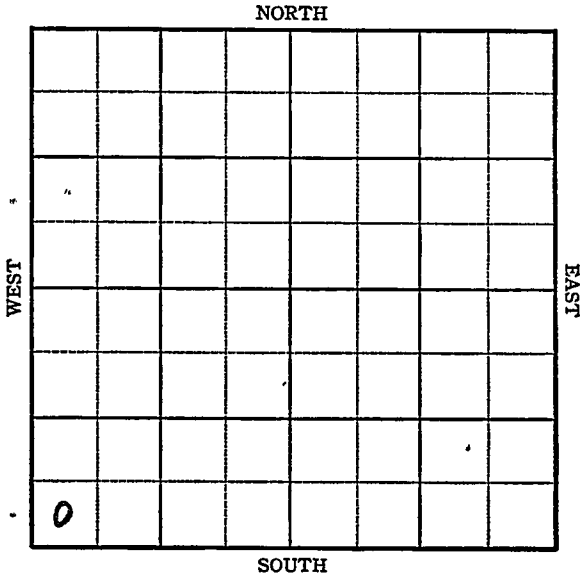

Sec. 6 Twp. 15 R. 13W

Well No. #1 Peck Farm

W. M. Peck Company

Sellens


_____ Ft. from N. Line

330 Ft. from S. Line

_____ Ft. from E. Line

330 Ft. from W. Line

SW/c

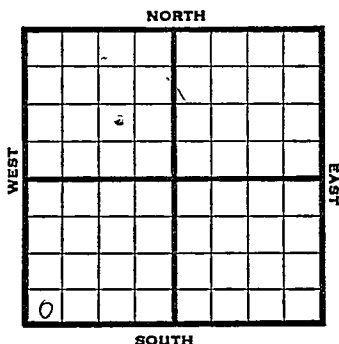

Elev. 1837

REPORT

1945

12/19	Location
12/29	Rig.
1946	
1/10	"
1/17	"
1/24	"
1/31	"
2/7	"
2/14	Spud.
2/21	471' run 12".
2/28	12" - 471' C.O.
3/4	Drlg. 685'
3/14	Anhy 821' 10" - 828'
	Drlg. 1275'
3/21	Drlg. 2145'
3/28	2350' U.R.
4/4	8" @ 2515
	Drlg. 2518'
4/10	Drlg 2725
4/16	Topeka 2717
	Lans 3016-7" @ 3018
	Drlg 3102
4/23	TD 3116-7" @ 3103
	RUST
5/1	1000 acid Pump 1 oil 1 WPH

OVER

Kansas Pool Name Sellens

KANSAS

Map No. 11-23 Sec. 6 Twp. 15 R. 13W

Well No. 1 Peck

W.I. Peck Company

W.I. Peck Contractor

S.J/c

SECTION PLAT

 Ft. from N. Line

330 Ft. from S. Line

 Ft. from E. Line

330 Ft. from W. Line

Russell

RECORD

Location X

Rig up

Drilling and Remarks:

Cased in., ft.

Sand

Gas

Oil

Total Depth

PRODUCTION

1st 24 hrs. Nat.

1st 24 hrs. after shot

Gas Cu. Ft.

Dry Hole

Abandoned

Date

DEC 1 9 1945 19

S. J. LEWIS Scout

KANSAS ~~KANSAS~~ Pool Name Frapp
 Map No. 73 Sec. 6 Twp. 15 R. 13W
 Well No. 1 Peck

W.M. Peck Company

COMPLETED

Contractor

SW/c

E. 1887
SECTION PLAT

_____ Ft. from N. Line
330 Ft. from S. Line
 _____ Ft. from E. Line
330 Ft. from W. Line

Russell County

Location _____

Rig up _____

Drilling and Remarks:

Lans 3016
7" @ 3018
1250 @ well
Ramp 3000 to 3016
P.D.
40 @ 3016

RECORD

Cased _____ in., _____ ft.
 Sand _____
 Gas _____
 Oil _____
 Total Depth 3116

PRODUCTION

1st 24 hrs. Nat. _____
 1st 24 hrs. after shot _____
 Gas _____ Cu. Ft.
 Dry Hole _____
 Abandoned _____

Date

MAY 8 1946 19

S. J. LEWIS Scout

1946

5/8 Lans 3016
7" @ 3018
TD 3116'
1250 acid.
Pump 30 oil plus 30 W. Pot.
Grav. 40.0

COMPLETED