


Section 6 Township 15 Range 13W

Well No. #1 Peck

Company Jones, Shelburne & Farmer

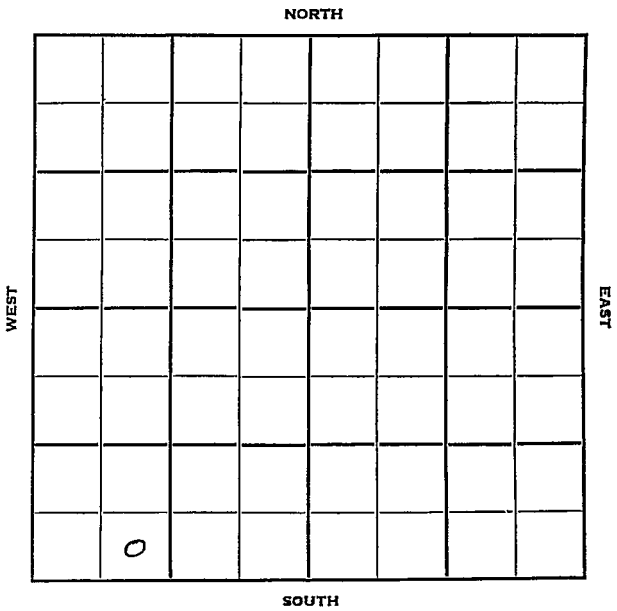

Russell

KANSAS 13W

Sec. 6 Twp. 15 R. 13W

Well No. #1 Peck Farm

Jones, Shelburne, & Farmer Company

J-S-F - Contr. Contractor

Hall-Gurney Pool


Ft. from N. Line

330' Ft. from S. Line

Ft. from E. Line

990' Ft. from W. Line

SE SW SW

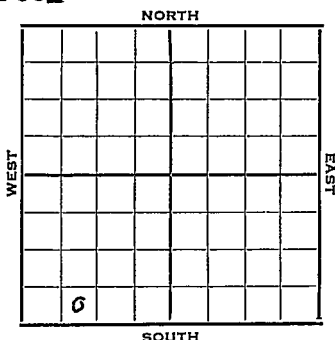

1952	Elev. 1850' REPORT
5/14	Spud 5-9-52 8" @ 120 Anhy 835 Drlg. 1992'
5/21	Topeka 2914' Heeb 2963' Tor. 2980' Douglas 2994' Lans. 3029' DST 3059-78 $\frac{1}{2}$ hr, 90' gas, 25' HO & GCM, 200#-15". Arb. 3312' SO TD 3315' 5" @ 3313'
5/28	WOC DP 3315' S/ 1 Boph for 4 hrs. 500 A
6/4	Spud 5-9-52 Oil Well TD 3315 8" @ 120 Anhy 835 Top 2914 Heeb. 2963 Tor. 2980 Doug 2994 Lans. 3029 DST 3059-78 opn $\frac{1}{2}$ hr. Rec. 90' gas 25' ho & gcm Arb. 3312 TD 3315 5" @ 3313 DP to 3315 S/1 boph 500 A S/9 boph Comp. 50 bopd

COMPLETED



Operator Jones, Shelburne & Farmer

Well No. 1 Farm Peck

Elev.	Location	SE	SW	SW
-------	----------	----	----	----

FIRST REPORT

330 Ft. From **S** Line **SW**

990 Ft. From W Line Quarter

1st. Report **MAY 14 1952**

Completion

Remarks

J-S-F - Contr.


Spudding Date **5-9-52**

Drig. Data Hall-Gurney Pool

8th @ 120 Anhy 835 drlg. 1992

J. G. McGEHEE

County Russell State Kansas
 Sec. 6 (Blk.) 15 (Sur.) 13W Map No.
 Operator Jones, Shelburne & Farmer
 Well No. 1 Farm Peck
 Elev. 1850 Location SE SW SW

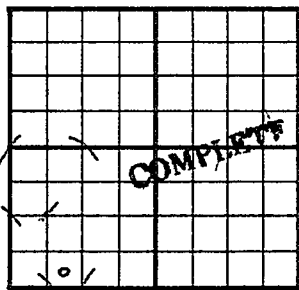

330 Ft. From S Line SW

990 Ft. From W Line Quarter

1st. Report

Completion JUN 4 1952

Remarks Hall-Gurney Pool
J-S-F - Contr.

Spudding Date 5-9-52

Drlg. Data Oil well TD 3315

8" @ 120 Anhy 835 Top. 2914

Heeb. 2963 Tor. 2980 Doug. 2994

Lans. 3029 DST 3059-78 open $\frac{1}{2}$ hr.

Rec. 90' gas 25' ho & gcm Arb. 3312

TD 3315 5" @ 3313 DP to 3315 S/ 1 boph

500 A S/ 9 boph Comp. 50. bopd

J. G McGEHEE