


Russell

Map No. KANSAS Sec. 6 Twp. 15 R. 13^W

Well No. 1- Berick Farm _____
Southern Oil Company

330 Ft. from N. Line
____ Ft. from S. Line
990 Ft. from E. Line
____ Ft. from W. Line
Elev. 1747

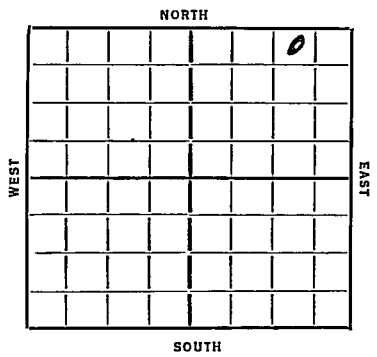

REPORT

1936
1/8 Rog.
1/17 Rig
1/24 Rog
1/31 Dlg 590 12" 240
2/7 " 1410
2/14 TD 1900 Rig Burned
2/21 Rep Rig
2/28 10" 2061 Dlg 2115
3/6 so 2080-85
 Dlg 4620
3/13 8"-2790 8 boilers oil 2836-38 T.D.
 U.R. 8"
3/20 8"- 2839 Show gas 2862 Show oil
 2869 Drlg. 2905 Est. 4 million gas
3/27 Flowed 60 bbls per day Est. 3½
 million gas. Acidizing.
4/2 T.D. 2926' Recement 8"-@- 2835'
 3000 acid.
4/10 --
4/16 Pump 508 bbls 18 hours.

OVER

4/22/36 - Pay 2835.
T.D. 2926.
2000 acid.
848 bbls.

COMPLETED

Map No. 73 Sec. 6 Twp. 15 R. 13W

Well No. 1-Berrick

Southern Oil Company

..... Contractor

SECTION PLAT

330 Ft. from N. Line

..... Ft. from S. Line

990 Ft. from E. Line

..... Ft. from W. Line

			0

FIRST REPORT

Location.....

Rig up.....

Drilling and Remarks:

Rig on ground

RECORD

Cased.....in.,ft.

Sand.....

Gas.....

Oil.....

Total Depth.....

PRODUCTION

1st 24 hrs. Nat.....

1st 24 hrs. after shot.....

Gas.....Cu. Ft.

Dry Hole.....

Abandoned.....

Date

JAN 8 1936 192.....

ORVAL MANNSCHRECK

.....Scout

Russell
 Map No. 73 Sec. 6 Twp. 15 R. 13

Well No. 1 Berrick

Southern Oil Company

Contractor

SECTION PLAT

			0

030 Ft. from N. Line

..... Ft. from S. Line

990 Ft. from E. Line

..... Ft. from W. Line

COMPLETED

Location.....

Rig up.....

Drilling and Remarks:

Pay 2835.

2000 acid

848 8 1/2 hr.

RECORD

Cased..... in., ft.

Sand.....

Gas.....

Oil.....

Total Depth 2926

PRODUCTION

1st 24 hrs. Nat.....

1st 24 hrs. after shot.....

Gas..... Cu. Ft.

Dry Hole.....

Abandoned.....

Date

APR 22 1936

S. J. LEWIS

192

Scout