

KANSAS

Form 51-5M-7-39-Palace

Russell


~~O.W.W.O.~~

Section 6 Township 15 Range 13-W

Well No. #1 Berrick "A"

Company Southern

NORTH **Coralena Pool**

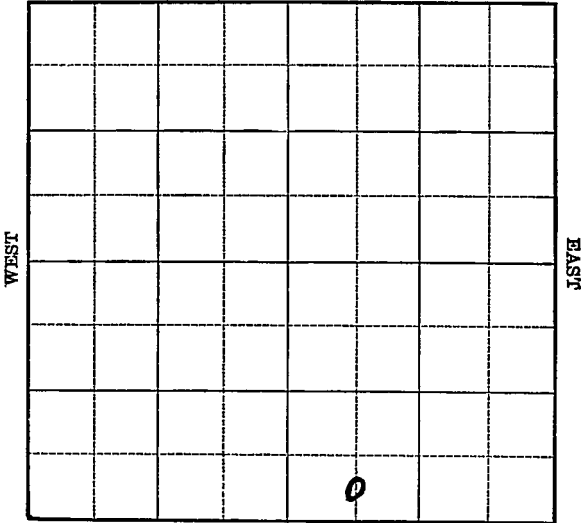

SOUTH

Sec. 6 Twp. 15 R. 13-WWell No. #1 Berrick "A" Farm \_\_\_\_\_

Southern \_\_\_\_\_ Company

(Coralena)


\_\_\_\_\_ Ft. from N. Line

330 Ft. from S. Line

\_\_\_\_\_ Ft. from E. Line

660 Ft. from W. Line

Elev. 1816

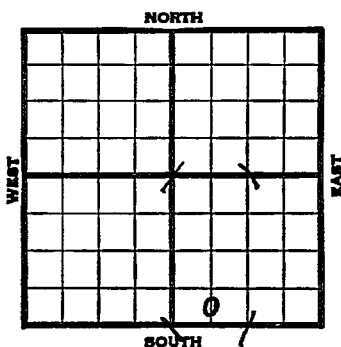

1940

REPORT

2/28

Location

3/8

10" - 288' WOC.

3/14

Drlg. 750'

3/21

Lans. 2995' Sat. 3014-18' T.D.

7" - 3014' RUST.

3/28

1000 acid. Pump 8 bbls. oil 24  
hours. Drlg. 3055'

4/4

Drlg. 3223'

4/12

Core 3270-72' Arb. 3271'

Core 3286-90' no shows.

Core 3290-93' recovered 6".

Show oil.

4/17

Lans. 2995'

7" - 3014'

T.D. 3294½'

3000 acid.

Water.

OVER

ABANDONED

Map No. 73 Sec. 6 Twp. 15 R. 13WWell No. 1 Berrick "A"Southern

Company

Contractor

**FIRST REPORT**

G S L SW SE

**SECTION PLAT**


         Ft. from N. Line330 Ft. from S. Line         Ft. from E. Line660 Ft. from W. Line**CORALENA POOL**Location XRig up         

Drilling and Remarks:

**RECORD**Cased          in.,          ft.Sand         Gas         Oil         Total Depth         **PRODUCTION**1st 24 hrs. Nat.         1st 24 hrs. after shot         Gas          Cu. Ft.Dry Hole         Abandoned         

Date

FEB 28 194019S. J. KEWIS

Scout

Map No. 73 Sec. 6 Twp. 15 R. 13WWell No. 1 Berrick "A"Southern Company

Contractor

ABANDONED

C S L SW SE

\_\_\_\_\_ Ft. from N. Line

330 Ft. from S. Line

\_\_\_\_\_ Ft. from E. Line

660 Ft. from W. Line

CORALENA POOL

## SECTION PLAT


Location \_\_\_\_\_

Rig up \_\_\_\_\_

Drilling and Remarks:

*Case. 2995  
7" C3014  
3800 acid  
Water.*

## RECORD

Cased \_\_\_\_\_ in., \_\_\_\_\_ ft.

Sand \_\_\_\_\_

Gas \_\_\_\_\_

Oil \_\_\_\_\_

Total Depth 3294 1/2

## PRODUCTION

1st 24 hrs. Nat. \_\_\_\_\_

1st 24 hrs. after shot \_\_\_\_\_

Gas \_\_\_\_\_ Cu. Ft.

Dry Hole \_\_\_\_\_

Abandoned \_\_\_\_\_

Date

APR 17 1940

19

S. J. LEWIS Scout