


Section 6 Township 15 Range 13W

Well No. #5 Berrick

Company C R A

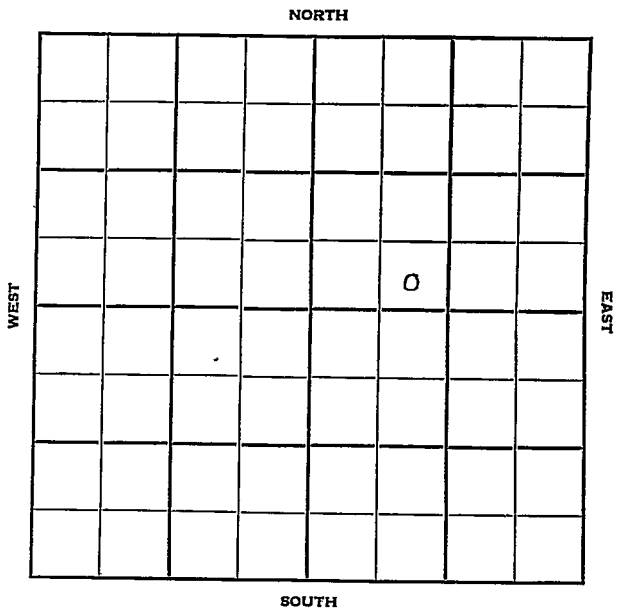

Russell

KANSAS

Sec. 6 Twp. 15 R. 13 WWell No. # 5 Berrick FarmC R A CompanyC R A Contractor

Trapp Pool


Ft. from N. Line

330 Ft. from S. Line

Ft. from E. Line

990 Ft. from W. Line

SE SW NE

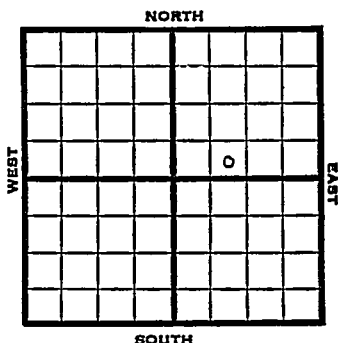

Elev. 1843' REPORT

1951

9/12

Spud 9-10-51

Anhy 828' 8" @ 833' WOC

10/10

Spud 9-10-51

Oil Well TD 3301

Anhy 828

8" @ 833

Heeb. 2942

Lans. 3009

DST 3024-57 opn 1 hr

Rec. 90' ocm

Arb. 3291-93 5" @ 3291

DD 3296 B/1 $\frac{1}{4}$ boph 500 A

S/2 boph DD 3301

S/2 boph Comp. 61 bopd

COMPLETED

County **Russell** State **Kansas**

Sec. 6 (Blk. Twp.) 15 (Sur. Rge.) 13W Map No.

Operator C R A

Well No. 5 Farm Berrick

Elev.	Location	SE	SW	NE
-------	----------	----	----	----

0

FIRST REPORT

330 Ft. From S Line NE

990 Ft. From W Line Quarter

1st. Report SEP 12 1951

Completion

Remarks

C R A - Contr.

Spudding Date 9-10-51

Drig. Data Trapp Pool

Anhv 828 8ⁿ @ 833 WOC

J. E. TYRA

Tap Pool

O.W.W.
Co. Feet

S-513-B

County Russell Elev. 1843 DF
Sec. 6 Twp. 15S Rge. 13W
Company C. R. A.
Farm Name Berrick No. 5

TOPS	DEPTH	LOG	DATUM
Anh.			
Tp.			
H.			
Tr.			
Dg.			
B.L.			
L. <u>K.</u>	<u>3009</u>		
K.C.			
B.K.C.			
Ce.			
C.			
M.			
M.			
K.			
Mz.			
Mq.			
V.			
S.			
S.			
A.	<u>3288</u>		
R.			
Pf.			
G.			
T.D.			

Loc. in Sec.

SE SW NE

(O.W.W.Ø)

Geol.

Contr.

Pool

Trapp

FIRST REPORT

AUG 27 38

COMPLETE

Date Comm.

OTD 3301, 5" @ 3291, Arb well, Comp.

10-10-51 CO 12/ 3231-34 20/ 3195-3200

500 A 400 jell A 32/ 3102-10

20/ 3090-95 2000 A 6000 A

Comp. 165 bopd