


Section 6 Township 15 Range 13W

Well No. #4 Berrick

Company Murfin Drlg.

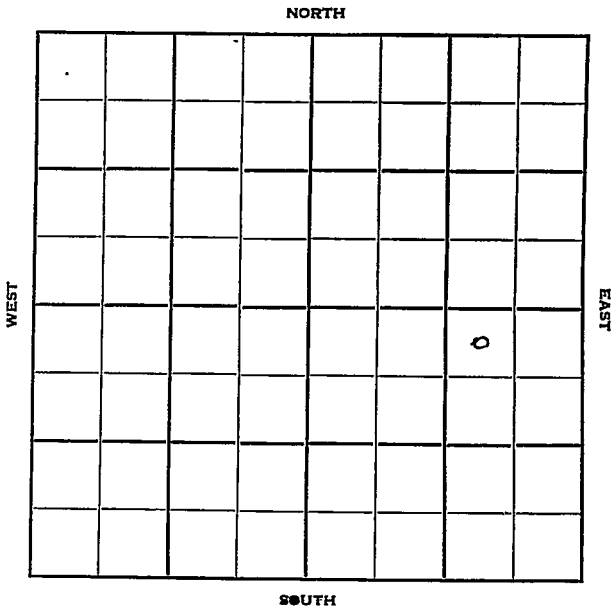

Sec. 6 Twp. 15 R. 10W

Well No. #1 Berrick Farm

Murfin Drlg. Company

Muffin Drlg. Contractor

Trapp Pool


330 Ft. from N. Line

\_\_\_\_\_ Ft. from S. Line

990 Ft. from E. Line

\_\_\_\_\_ Ft. from W. Line

NW NE SE

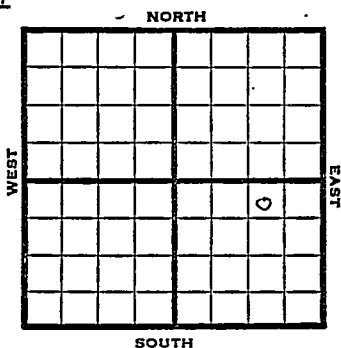

1951 Elev. 1797' REPORT

11/21 Spud 11-17-51  
8" @ 190  
Drlg. 1620'

1952  
1/2 Spud 11-17-51  
Oil Well TD 3263  
8" @ 190  
Heeb. 2910 Dodge 2927  
Ians. 2974  
DST 3001-15 open 1 hr.  
Rec. 490' mud & wtr.  
Arb. 3255  
DST 3253-61 open 1/2 hr. Rec. 21' OCM  
TD 3261 5" @ 3256 DD 3263  
1500 A B/ 3/4 BOPH  
Comp. 30 BOPD

**COMPLETED**



