


Map No. Kansas Sec. 28 Twp. 33 R. 3-E

Well No. 12 - Caldwell Farm  
Barnsdale Oil Company

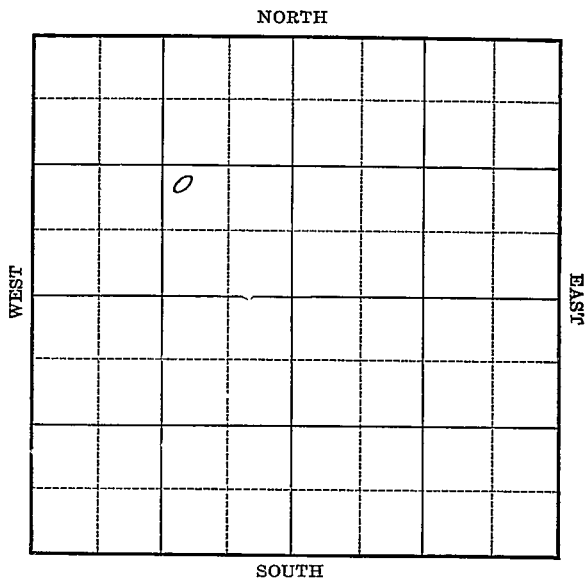

Location \_\_\_\_\_

Drilling Remarks \_\_\_\_\_

\_\_\_\_\_

\_\_\_\_\_

**RECORD**

Cased \_\_\_\_\_ in. \_\_\_\_\_ ft.

Sand \_\_\_\_\_

Gas \_\_\_\_\_

Oil \_\_\_\_\_

Total Depth \_\_\_\_\_

Rig Up \_\_\_\_\_

Drilling Remarks \_\_\_\_\_

\_\_\_\_\_

\_\_\_\_\_

**PRODUCTION**

1st 24 hrs. Nat. \_\_\_\_\_

1st 24 hrs. after shot \_\_\_\_\_

Gas \_\_\_\_\_ cu. ft.

Dry Hole \_\_\_\_\_

Abandoned \_\_\_\_\_

Cowley

Map No. Kansas Sec. 28 Twp. 33 R. 3E


Well No. 12 Caldwell Farm  
Barnsdall Oil Company

\_\_\_\_\_ Ft. from N. Line

990 Ft. from S. Line

990 Ft. from E. Line

\_\_\_\_\_ Ft. from W. Line

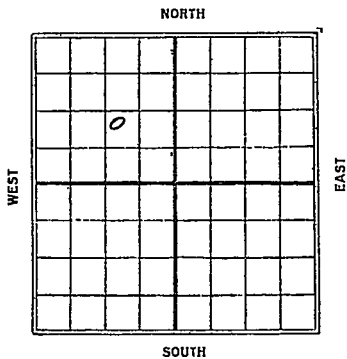

Date	REPORT
1926	
4/7	Cellar
4/13	P.O. <del>29</del>
4/21	Rig
4/29	Spud.
5/5	Dlg 700'
5/12	" 815'
5/19	" 1725'
5/26	" 1965'
6/2	T.D. 1960 drlg by bit.
6/9	Set 8" C 1940
6/16	No report
6/23	T.D. 2330 U.P. 8"
6/30	Dlg 2560
7/14	" 3080
7/22	300' oil in hole, top sand
	3249, total depth 3472
7/28	Sand 3249 - 3272 15 gts
	swabbed 25 bbls

Map No. *KF Country* **KANSAS** Sec. *28* Twp. *33* R. *3E*

Well No. *12 Caldwell*

*Barnsdall Oil* Company

Contractor

**SECTION PLAT**

-----Ft. from N. Line

*990* Ft. from S. Line

*990* Ft. from E. Line

-----Ft. from W. Line

	0		

**FIRST REPORTS**

Location -----

Rig up -----

Drilling and Remarks:

*Cellar  
all Waitt Phillips  
is now called  
Barnsdall.*

**RECORD**

Cased ----- in., ----- ft.

Sand -----

Gas -----

Oil -----

Total Depth -----

**PRODUCTION**

1st 24 hrs. Nat. -----

1st 24 hrs. after shot -----

Gas ----- Cu. Ft.

Dry Hole -----

Abandoned -----

Date

**APR 7 1926**

**S. J. LEWIS**

Scout

Map No. **KANSAS** Sec. *28* Twp. *23* R. *3E*

Well No. *12 Caldwell*

*Barusclatt Oil* Company

Contractor

SECTION PLAT

----- Ft. from N. Line

*990* Ft. from S. Line

*990* Ft. from E. Line

----- Ft. from W. Line

	0		

COMPLETED

Location -----

Rig up -----

Drilling and Remarks:

*Sand 3249 &  
3272  
Shot 109 to  
swatched 25  
ft*

RECORD

Cased ----- in., ----- ft.

Sand -----

Gas -----

Oil -----

Total Depth -----

PRODUCTION

1st 24 hrs. Nat. -----

1st 24 hrs. after shot -----

Gas ----- Cu. Ft.

Dry Hole -----

Abandoned -----

Date

*JUL 28 1926*

*S. J. LEWIS.*

Scout