

Map No. Sec. Twp. R.

Well No. Farm


..... Company

..... Ft. from N. Line

..... Ft. from S. Line

..... Ft. from E. Line

..... Ft. from W. Line

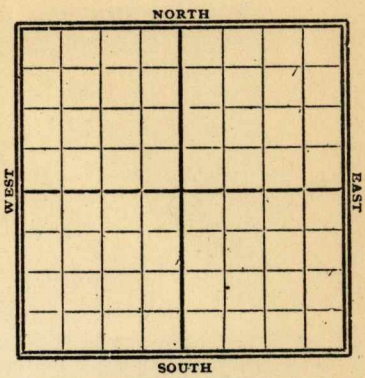

1917

Date

REPORT

Gypsy Records

Jan

Abd T.D. 3080'

MAP NO. K12 **KANSAS** SEC. 24 TWP. 30S R. 3E

WELL NO. 7 Houser

Commonwealth COMPANY

CONTRACTOR

SECTION PLAT

ABANDONED

_____ FT. FROM N. LINE

_____ FT. FROM S. LINE

_____ FT. FROM E. LINE

_____ FT. FROM W. LINE

| | | | |
|--|--|--|---|
| | | | |
| | | | |
| | | | |
| | | | 0 |

LOCATION _____

RIG UP _____

DRILLING AND REMARKS:

ole

RECORD

CASED _____ IN. _____ FT.

SAND _____

GAS _____

OIL _____

TOTAL DEPTH 3080

PRODUCTION

1ST 24 HRS. NAT. _____

1ST 24 HRS. AFTER SHOT _____

GAS _____ CU. FT.

DRY HOLE _____

ABANDONED _____

DATE

Jan 17 192 SCOUT