


Map No. _____ Sec. 24 Twp. 30 R. 3

Well No. 1-Martin (Mapped Husu) Farm
Commonwealth Oil Company

NORTH

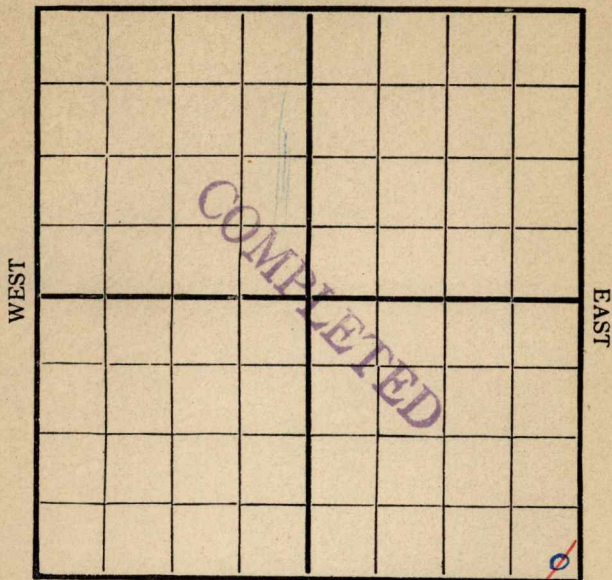

SOUTH

Location _____

Rig Up 8716

Drilling Remarks:

Drilling Remarks:

9/30 - Pipe on ground
10/14 - Rigging up
10/21 - 355
10/28 - 800
11/4 = 960
11/18 - 1080 = 11/25 - 12/2
12/9 = 1470
12/23 - 1925 = 12/30
1/6 = 2300
1/13 = 2520
1/20 = 2610

RECORD


PRODUCTION

Cased _____ in _____ Ft.
 Sand _____
 Gas _____
 Oil _____
 Total Depth _____

1st 24 hrs. Nat. _____
 1st 24 hrs. after shot _____
 Gas _____ Cu. Ft.
 Dry Hole _____
 Abandoned _____

Map No. _____ Sec. 24 Twp. 30 R. 3
Well No. 1 Martin - mapped House Farm
Commonwealth Oil Company

NORTH

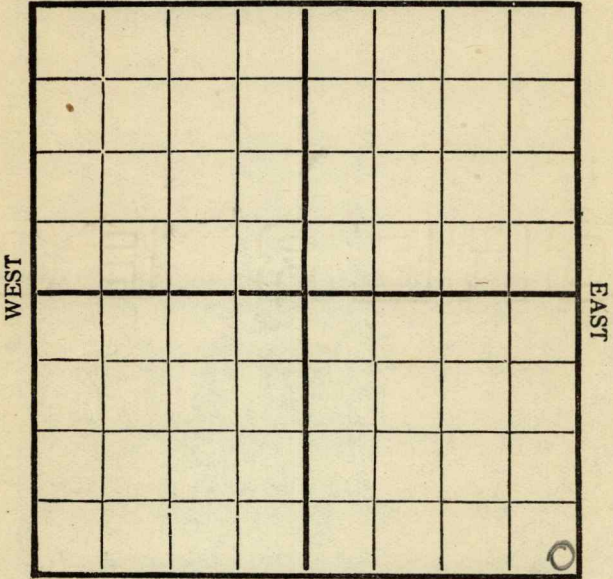

SOUTH


<p>Location _____</p> <p>Rig Up <input checked="" type="checkbox"/></p> <p>Drilling and remarks _____</p>	<p style="text-align: center;">RECORD</p> <p>Cased _____ in. _____ Ft.</p> <p>Sand _____</p> <p>Gas _____</p> <p>Oil _____</p> <p>Total Depth _____</p> <hr/> <p style="text-align: center;">PRODUCTION</p> <p>1st 24 hrs. Nat. _____</p> <p>First 24 h. s. after shot _____</p> <p>Gas _____ Cu. Ft.</p> <p>Dry Hole _____</p> <p>Abandoned _____</p>
---	--

Date 8/16, 1916 B. H. Farns Scout

Map No. _____ Sec. 24 Twp. 30 R. 3

Well No. 1 Martin Farm
Commonwealth Company

NORTH

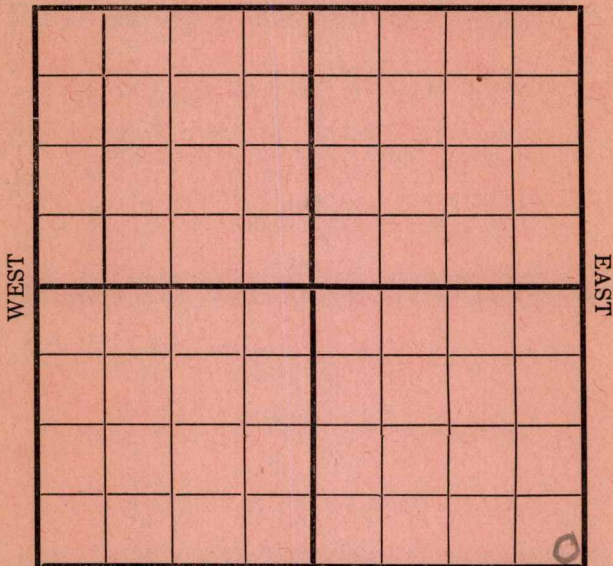

SOUTH

RECORD

Location _____

Cased _____ in. _____ Ft.

Rig Up

Sand _____

Drilling and remarks _____

Gas _____

Oil _____

Total Depth _____

PRODUCTION

1st 24 hrs. Nat. _____

1st 24 hrs. after shot _____

Gas _____ Cu. Ft.

Dry Hole _____

Abandoned _____

Date

8/19, 1916 H. Forns Scout


Cowley

Map No. _____ Sec. *24* Twp. *30* R. *3*

Well No. *1* *Martin's* Farm

Commonwealth Company

NORTH

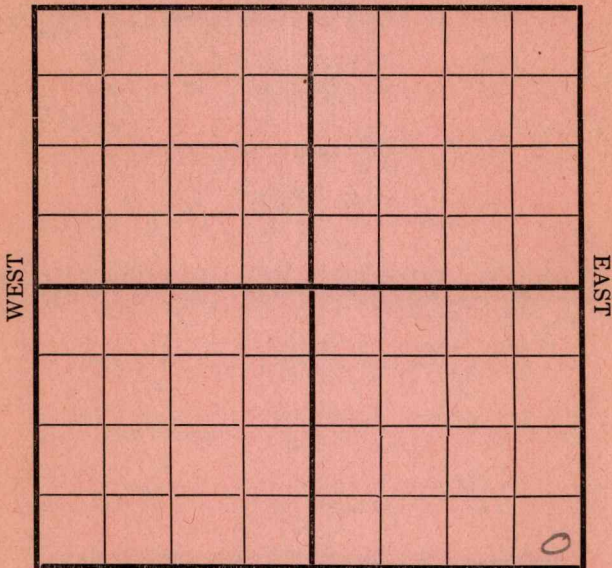

SOUTH

Location _____

Rig Up _____

Drilling and remarks _____

RECORD

Cased _____ in. _____ Ft.

Sand _____

Gas _____

Oil _____

Total Depth _____

PRODUCTION

1st 24 hrs. Nat. _____

1st 24 hrs. after shot _____

Gas _____ Cu. Ft.

Dry Hole _____

Abandoned _____

Date

8/26, 191 *6*


E. H. West Scout

Cowley

Map No. _____ Sec. *24* Twp. *30* R. *3*

Well No. *1* *Martin* Farm
 _____ *Commonwealth O* Company

NORTH

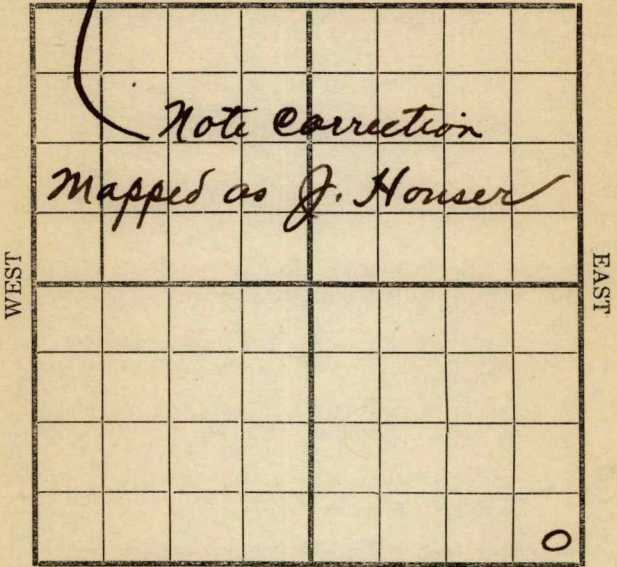

SOUTH

Location _____
 Rig Up _____
 Drilling and remarks _____

RECORD

Cased _____ in. _____ Ft.
 Sand _____
 Gas _____
 Oil _____
 Total Depth _____

PRODUCTION


1st 24 hrs. Nat. _____
 1st 24 hrs. after shot _____
 Gas _____ Cu. Ft.
 Dry Hole _____
 Abandoned _____

Date *9/2*, 191 *6*

E. Houser Scout

Map No. Cowley Sec. 24 Twp. 30 R. 3
 Well No. 1 Houser Farm
Commonwealth Oil Company

NORTH

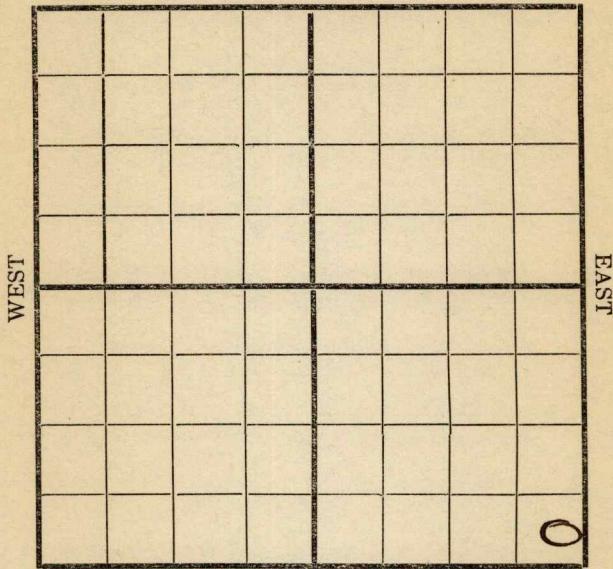

SOUTH

Location ✓
 Rig Up _____
 Drilling and remarks _____

RECORD

Cased _____ in. _____ Ft.
 Sand _____
 Gas _____
 Oil _____
 Total Depth _____

PRODUCTION

1st 24 hrs. Nat. _____
 1st 24 hrs. after shot _____
 Gas _____ Cu. Ft.
 Dry Hole _____
 Abandoned _____

Date 9/9, 1916

E. H. West Scout


Cowley

Map No. _____ Sec. *24* Twp. *30* R. *3*

Well No. *1 House* Farm _____

_____ *Commonwealth* Company

NORTH

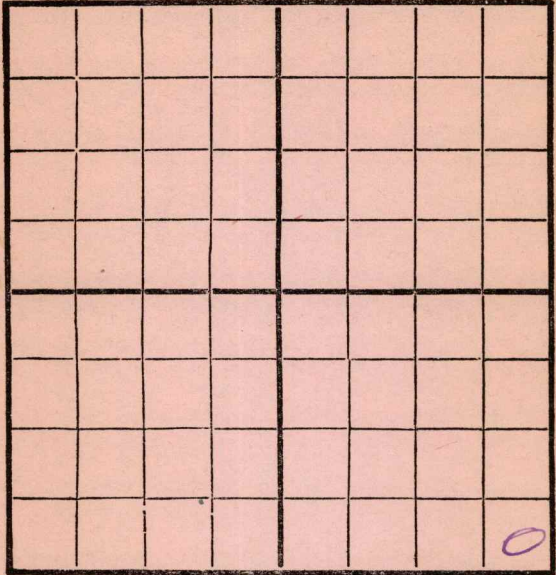

SOUTH

Location _____

Rig Up _____

Drilling and remarks _____

RECORD

Cased _____ in. _____ Ft.

Sand _____

Gas _____

Oil _____

Total Depth _____

PRODUCTION

1st 24 hrs. Nat. _____

First 24 hrs. after shot _____

Gas _____ Cu. Ft.

Dry Hole _____

Abandoned _____

Date

9/16


191 *6*

Exewent

Scout

Cowley
Map No. _____ Sec. *24* Twp. *30* R. *3*
Well No. *1 Hoases* Farm _____
Commonwealth Company

NORTH

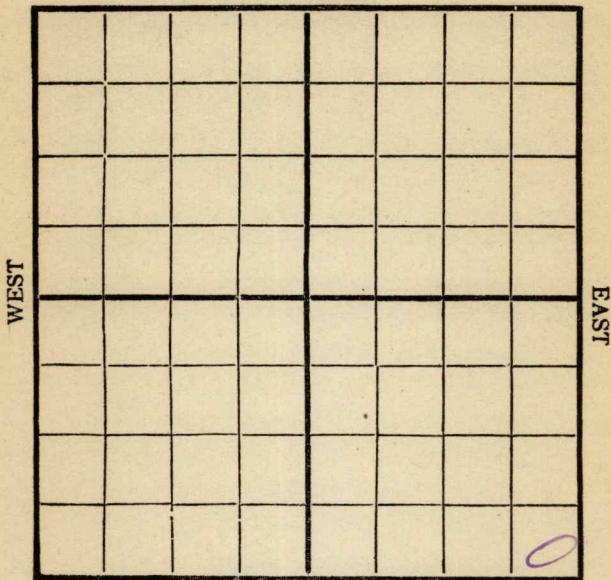

SOUTH

Location _____
Rig Up _____
Drilling and remarks _____

RECORD

Cased _____ in. _____ Ft.
Sand _____
Gas _____
Oil _____
Total Depth _____

PRODUCTION

1st 24 hrs. Nat. _____
First 24 hrs. after shot _____
Gas _____ Cu. Ft.
Dry Hole _____
Abandoned _____

Date

9/23, 191*6* *E. Hoases* Scout


Cowley

Map No. _____ Sec. *24* Twp. *30* R. *3*

Well No. *1 Houser* Farm _____

_____ *Commonwealth* Company

NORTH

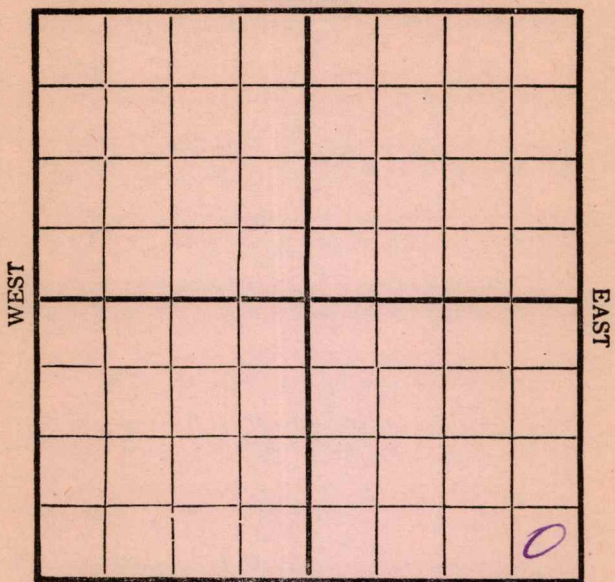

SOUTH

Location _____
 Rig Up _____
 Drilling and remarks
pipe on ground

RECORD

Cased _____ in. _____ Ft.
 Sand _____
 Gas _____
 Oil _____
 Total Depth _____

PRODUCTION

1st 24 hrs. Nat. _____
 First 24 hrs. after shot _____
 Gas _____ Cu. Ft.
 Dry Hole _____
 Abandoned _____

Date *9/30*, 191 *6*

E. West Scout


Cowley

Map No. _____ Sec. *24* Twp. *30* R. *3*

Well No. *1* *Houses* Farm _____

Commonwealth Oil Company

NORTH

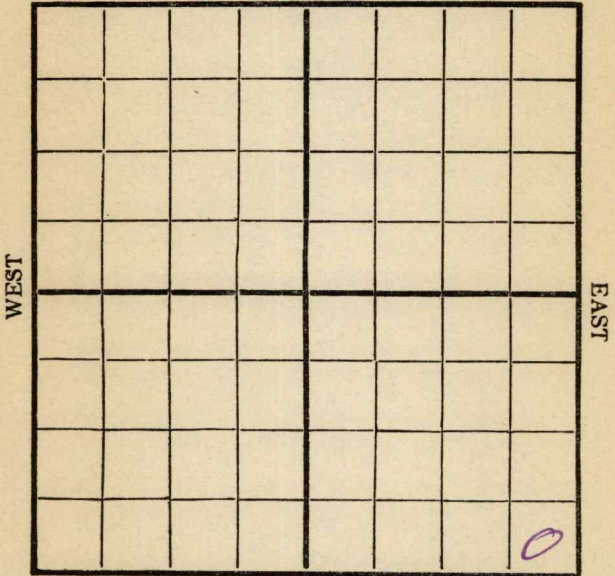

SOUTH

Location _____

Rig Up _____ ✓

Drilling and remarks _____

RECORD

Cased _____ in. _____ Ft.

Sand _____

Gas _____

Oil _____

Total Depth _____

PRODUCTION

1st 24 hrs. Nat. _____

1st 24 hrs. after shot _____

Gas _____ Cu. Ft.

Dry Hole _____

Abandoned _____

Date


10/7, 191 *6*

E. West

Scout

Map No. Cowley Sec. 24 Twp. 30 R. 3
Well No. 1 House Farm
Commonwealth Company

NORTH

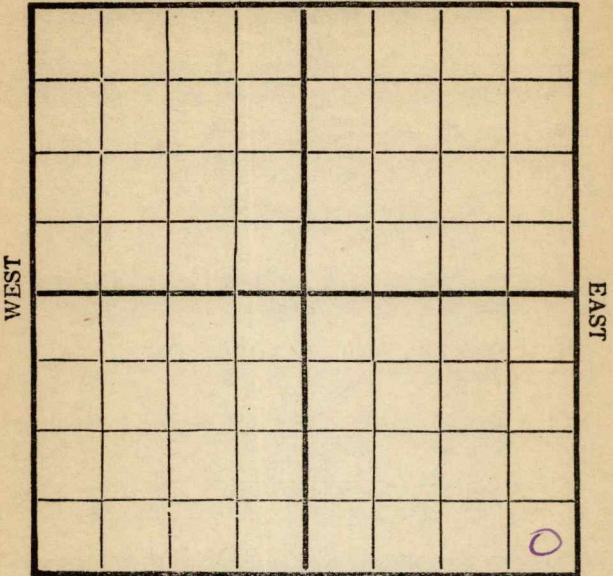

SOUTH

Location

Rig Up

Drilling and remarks

Rigging up

RECORD

Cased in. Ft.

Sand

Gas

Oil

Total Depth

PRODUCTION

1st 24 hrs. Nat.

First 24 hrs. after shot

Gas Cu. Ft.

Dry Hole

Abandoned

Date

10/14, 191 *6*

E. Everett

Scout


COWLEY

Map No. Sec. 24 Twp. 30 R. 3

Well No. 1 Houser Farm

Commonwealth Oil Company

NORTH

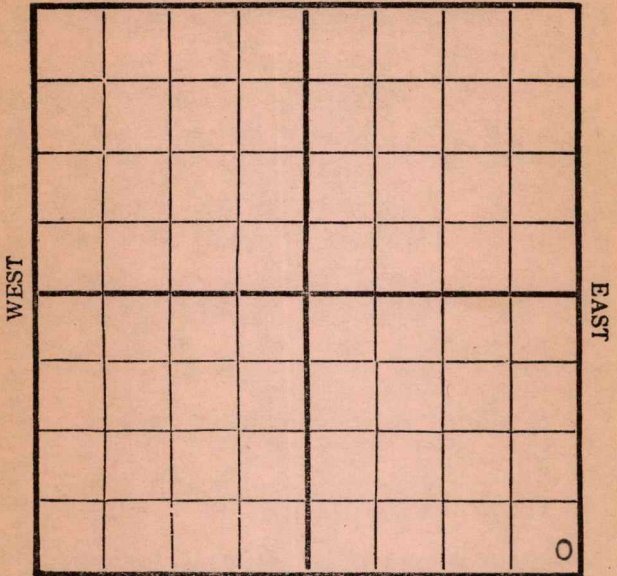

SOUTH

Location

Rig Up

Drilling and remarks

✓ 355

RECORD

Cased in. Ft.

Sand

Gas

Oil

Total Depth

PRODUCTION

1st 24 hrs. Nat.

First 24 hrs. after shot

Gas Cu. Ft.

Dry Hole

Abandoned

Date

OCT 21 1916

191.....

E. H. WEST Scout


COWLEY

Map No. _____ Sec. 24 Twp. 30 R. 3

Well No. 1 Houser Farm _____

_____ Commonwealth Oil Company

NORTH

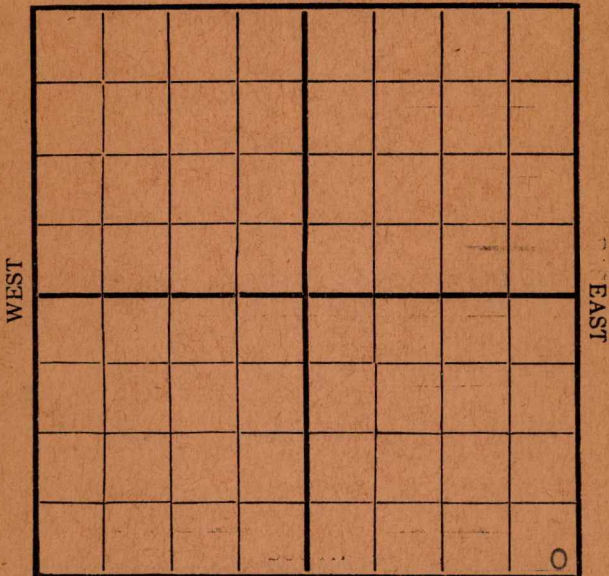

SOUTH

Location _____

Rig Up _____

Drilling and remarks

/ 800

RECORD

Cased _____ in. _____ Ft.

Sand _____

Gas _____

Oil _____

Total Depth _____

PRODUCTION

1st 24 hrs. Nat. _____

1st 24 hrs. after shot _____

Gas _____ Cu. Ft.

Dry Hole _____

Abandoned _____

Date


OCT 28 1916

191 _____

E. H. WEST

Scout

Map No. Cowley Sec. 24 Twp. 30 R. 3
 Well No. 1 Houser Farm
Commonwealth Oil Company

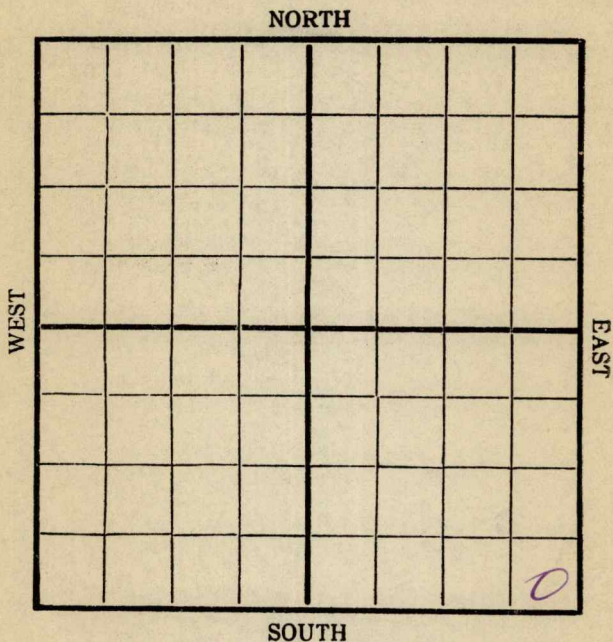

Location -----
 Rig Up -----
 Drilling and remarks

✓ 960

RECORD

Cased ----- in. ----- Ft.
 Sand -----
 Gas -----
 Oil -----
 Total Depth -----

PRODUCTION

1st 24 hrs. Nat. -----
 1st 24 hrs. after shot -----
 Gas ----- Cu. Ft.
 Dry Hole -----
 Abandoned -----

Date

11/4, 1916,

E. H. WEST

Scout


COWLEY

Map No. _____ Sec. 24 Twp. 30 R. 3

Well No. 1 Houser _____ Farm

_____ Commonwealth Oil Company

NORTH

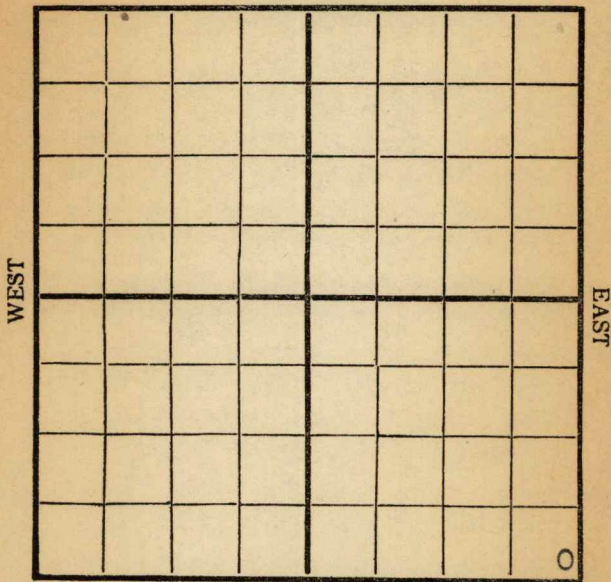

SOUTH

Location _____

Rig Up _____

Drilling and remarks

S.D. -960

RECORD

Cased _____ in. _____ Ft.

Sand _____

Gas _____

Oil _____

Total Depth _____

PRODUCTION

1st 24 hrs. Nat. _____

1st 24 hrs. after shot _____

Gas _____ Cu. Ft.

Dry Hole _____

Abandoned _____

Date

NOV 11 1916

191 _____

E. H. WEST

Scout


COWLEY

Map No. _____ Sec. 24 Twp. 30 R. 3

Well No. 1 Houser Farm _____

_____ Commonwealth Oil Company

NORTH

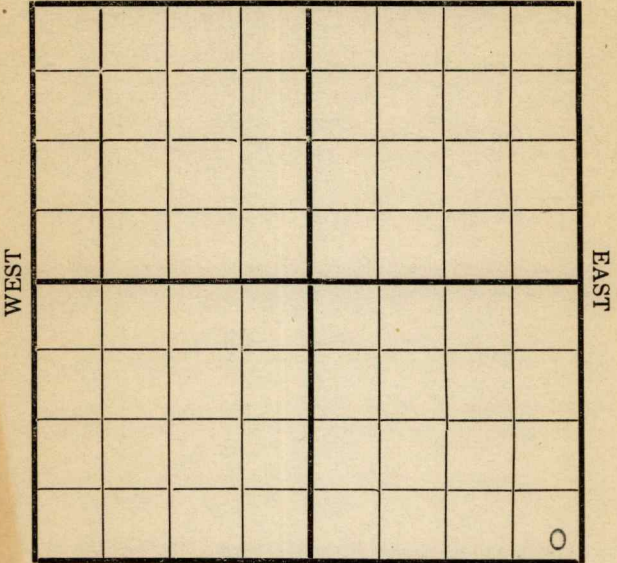

SOUTH

Location _____

Rig Up _____

Drilling and remarks

S.D. - 1080

RECORD

Cased _____ in. _____ Ft.

Sand _____

Gas _____

Oil _____

Total Depth _____

PRODUCTION

1st 24 hrs. Nat. _____

1st 24 hrs. after shot _____

Gas _____ Cu. Ft.

Dry Hole _____

Abandoned _____

Date

NOV 18 1916

E. H. WEST

_____, 191_____

_____ Scout


COWLEY

Map No. _____ Sec. 24 Twp. 30 R. 3

Well No. 1 Houser Farm _____

Commonwealth Oil Company

NORTH

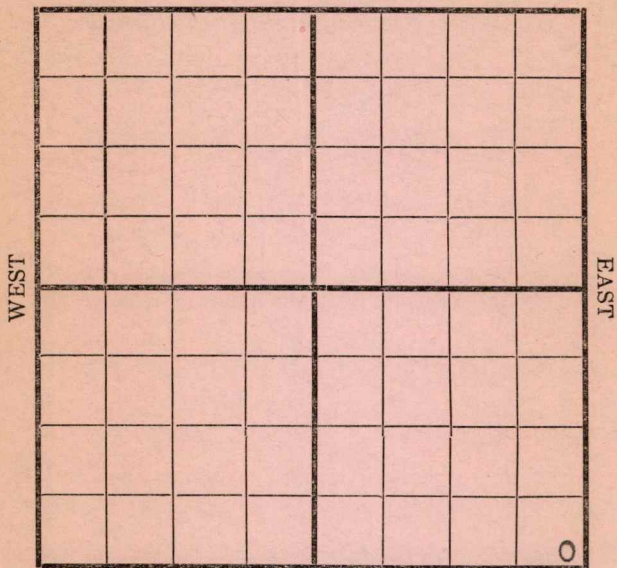

SOUTH

Location _____
 Rig Up _____
 Drilling and remarks
9.D. - 1080

RECORD

Cased _____ in. _____ Ft.
 Sand _____
 Gas _____
 Oil _____
 Total Depth _____

PRODUCTION

1st 24 hrs. Nat. _____
 1st 24 hrs. after shot _____
 Gas _____ Cu. Ft.
 Dry Hole _____
 Abandoned _____

Date
NOV 25 1916
 _____, 191_____

E. H. WEST Scout


COWLEY

Map No. Sec. 24 Twp. 30 R. 3

Well No. 1 Houser Farm

..... Commonwealth Company

NORTH

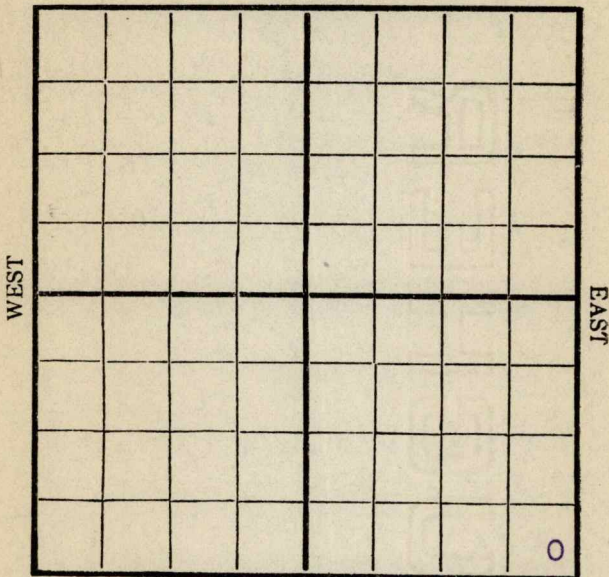

SOUTH

Location

Rig Up

Drilling and remarks

SA - 1080

RECORD

Cased in. Ft.

Sand

Gas

Oil

Total Depth

PRODUCTION

1st 24 hrs. Nat.

1st 24 hrs. after shot

Gas Cu. Ft.

Dry Hole

Abandoned

Date

DEC - 2 1916

191

E. H. WEST

Scout


COWLEY

Map No. _____ Sec. 24 Twp. 20 R. 3

Well No. 1 Houses Farm

Commonwealth Company

NORTH

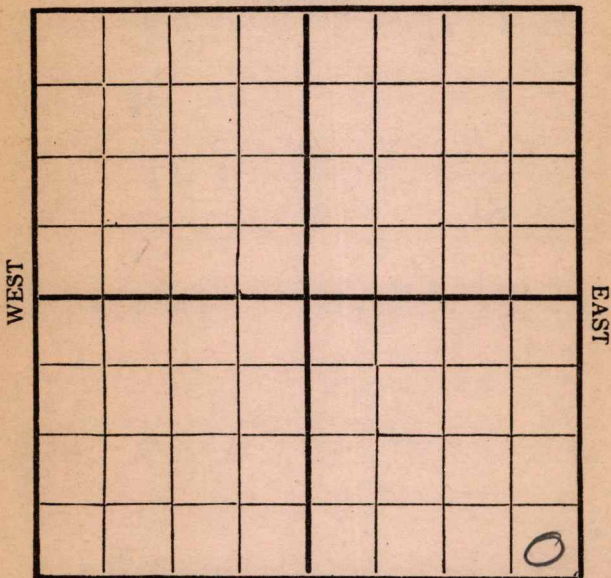

SOUTH

Location _____

Rig Up _____

Drilling and remarks

1470

RECORD

Cased _____ in. _____ Ft.

Sand _____

Gas _____

Oil _____

Total Depth _____

PRODUCTION

1st 24 hrs. Nat. _____

1st 24 hrs. after shot _____

Gas _____ Cu. Ft.

Dry Hole _____

Abandoned _____

Date

DEC - 9 1916

191

E. H. WEST

Scout


COWLEY

Map No. _____ Sec. 24 Twp. 30 R. 3

Well No. 1 Houser Farm _____

_____ Commonwealth Company _____

NORTH

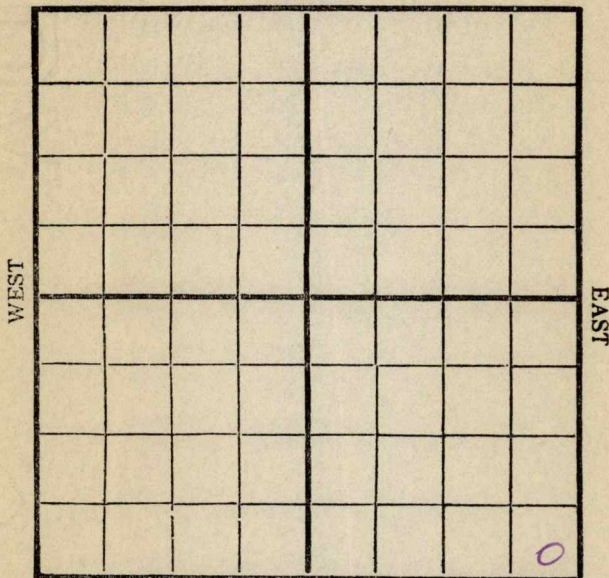

SOUTH

Location _____

Rig Up _____

Drilling and remarks

UR to 1800

RECORD

Cased _____ in. _____ Ft.

Sand _____

Gas _____

Oil _____

Total Depth _____

PRODUCTION

1st 24 hrs. Nat. _____

1st 24 hrs. after shot _____

Gas _____ Cu. Ft.

Dry Hole _____

Abandoned _____

Date DEC 16 1916


_____, 191____ E. H. WEST Scout

COWLEY

Map No. _____ Sec. 24 Twp. 30 R. 3

Well No. 1 House Farm _____
_____ Commonwealth Company

NORTH

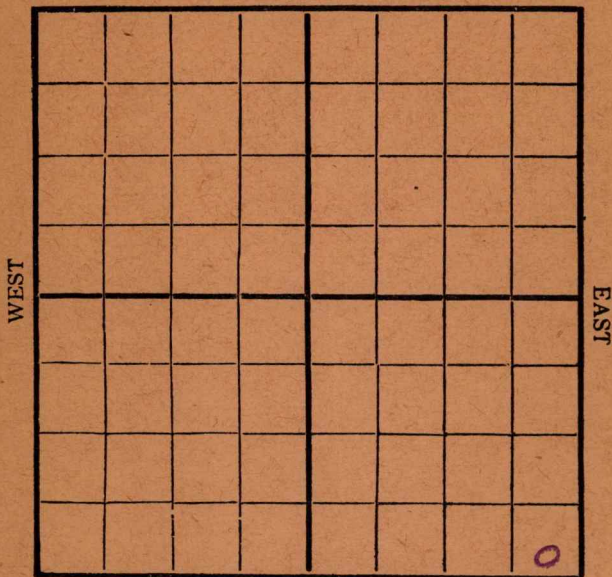

SOUTH

Location _____

Rig Up _____

Drilling and remarks

✓
1925

RECORD

Cased _____ in. _____ Ft.

Sand _____

Gas _____

Oil _____

Total Depth _____

PRODUCTION

1st 24 hrs. Nat. _____

1st 24 hrs. after shot _____

Gas _____ Cu. Ft.

Dry Hole _____

Abandoned _____

Date

DEC 23 1916

191

E. H. WEST


Scout

Map No. COWLEY Sec. 24 Twp. 30 R. 3

Well No. 1 Hauser Farm
Commonwealth Company

NORTH

WEST

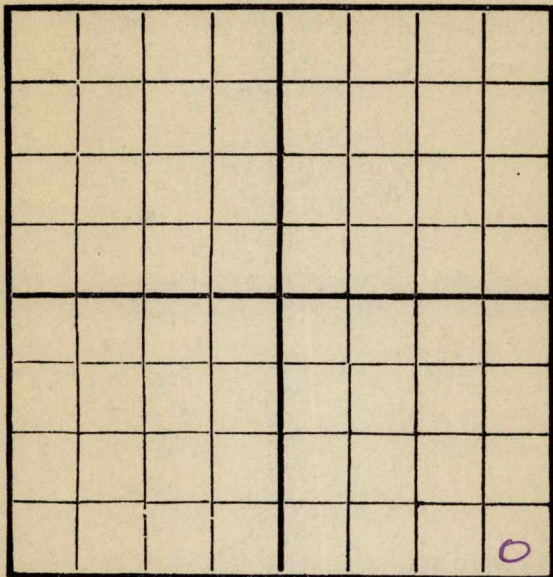

EAST

SOUTH

Location

Rig Up

Drilling and remarks

SD-1925

RECORD

Cased in. Ft.

Sand

Gas

Oil

Total Depth

PRODUCTION

1st 24 hrs. Nat.

1st 24 hrs. after shot

Gas Cu. Ft.

Dry Hole

Abandoned

Date

DEC 30 1916

E. H. WEST

191.....

Scout


COWLEY

Map No. _____ Sec. 24 Twp. 30 R. 3

Well No. 1 Houses Farm _____

_____ Commonwealth Company

NORTH

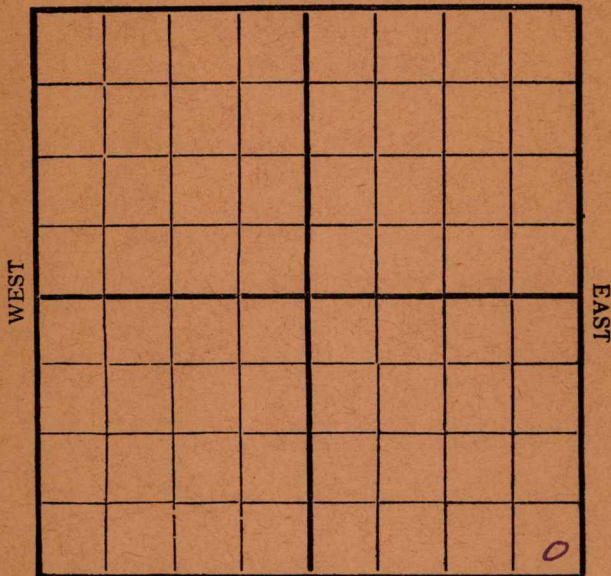

SOUTH

Location _____

Rig Up _____

Drilling and remarks

2300

RECORD

Cased _____ in. _____ Ft.

Sand _____

Gas _____

Oil _____

Total Depth _____

PRODUCTION

1st 24 hrs. Nat. _____

1st 24 hrs. after shot _____

Gas _____ Cu. Ft.

Dry Hole _____

Abandoned _____

Date

JAN - 6 1917

191

E. H. WEST

Scout


COWLEY

Map No. _____ Sec. 24 Twp. 30 R. 3

Well No. 1 Hooper Farm _____

Commonwealth Company

NORTH

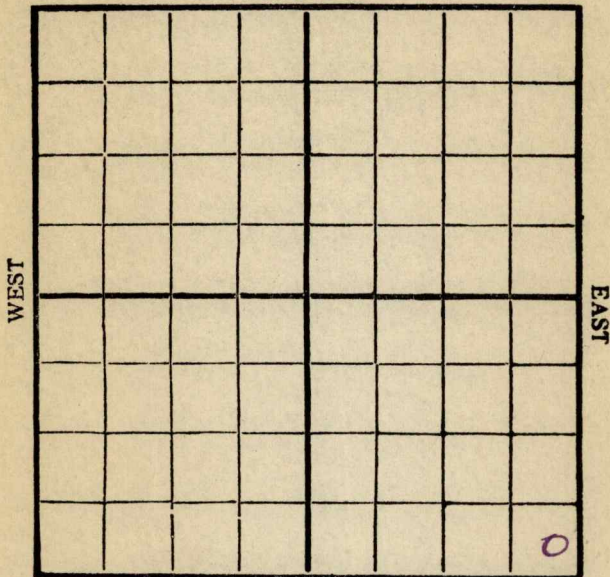

SOUTH

Location _____

Rig Up _____

Drilling and remarks

2520

RECORD

Cased _____ in. _____ Ft.

Sand _____

Gas _____

Oil _____

Total Depth _____

PRODUCTION

1st 24 hrs. Nat. _____

1st 24 hrs. after shot _____

Gas _____ Cu. Ft.

Dry Hole _____

Abandoned _____

Date

JAN 13 1917

, 191

E. H. WEST

Scout

COWLEY


Map No. _____ Sec. 24 Twp. 30 R. 3

Well No. 1 Houser _____ Farm
_____ Commonwealth Company

NORTH

WEST

EAST

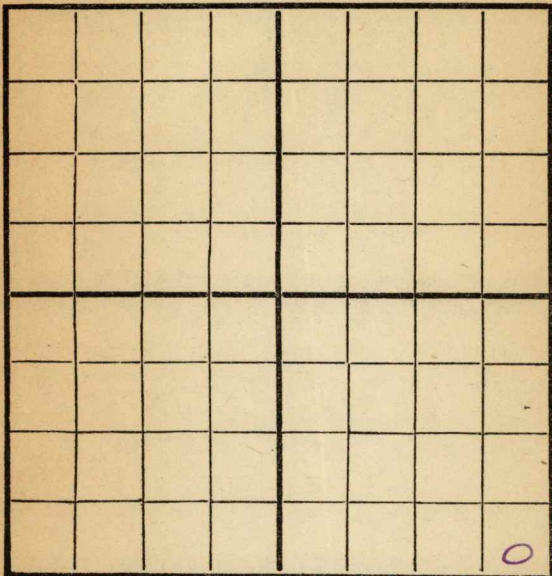

SOUTH

Location _____
Rig Up _____
Drilling and remarks

2610

RECORD

Cased _____ in. _____ Ft.
Sand _____
Gas _____
Oil _____
Total Depth _____

PRODUCTION

1st 24 hrs. Nat. _____
1st 24 hrs. after shot _____
Gas _____ Cu. Ft.
Dry Hole _____
Abandoned _____

Date

JAN 20 1917

E. H. WEST

191

Scout


COWLEY

Map No. _____ Sec. 24 Twp. 30 R. 3

Well No. 1 House _____ Farm

_____ Commonwealth Company

NORTH

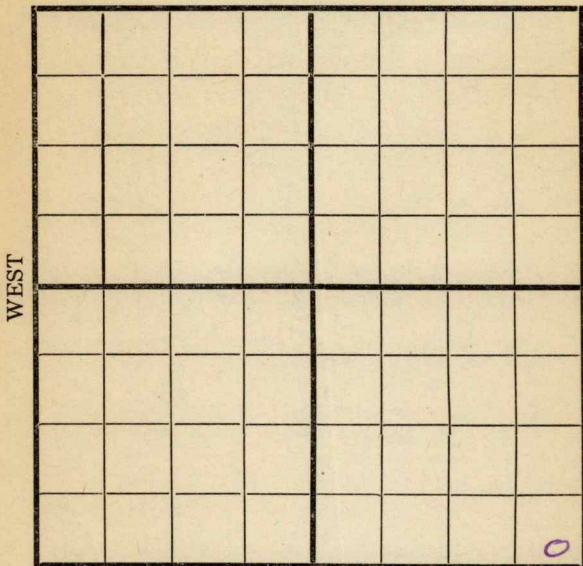

SOUTH

Location _____

Rig Up _____

Drilling and remarks

✓ 2870

about ready to abandon

RECORD

Cased _____ in. _____ Ft.

Sand _____

Gas _____

Oil _____

Total Depth _____

PRODUCTION

1st 24 hrs. Nat. _____

1st 24 hrs. after shot. _____

Gas _____ Cu. Ft.

Dry Hole _____

Abandoned _____

Date

JAN 27 1917


191

E. H. WEST

Scout

COWLEY
Map No. _____ Sec. 24 Twp. 30 R. 3
Well No. 1 House Farm _____
_____ Commonwealth Company

NORTH

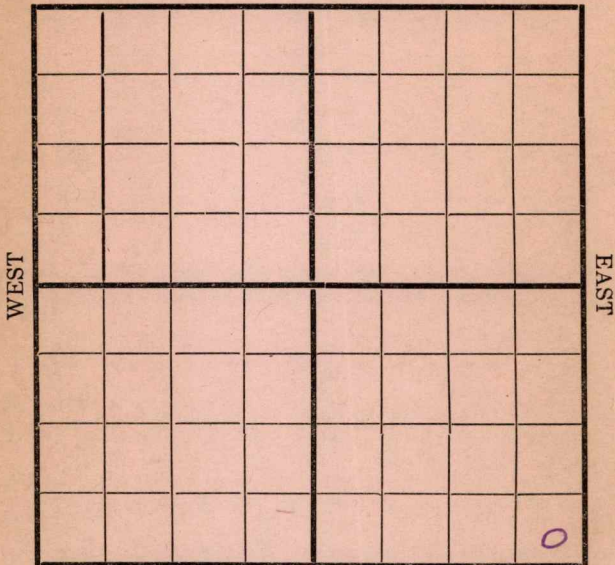

SOUTH

Location _____
 Rig Up _____
 Drilling and remarks
2970
About ready
to abandon

RECORD

Cased _____ in. _____ Ft.
 Sand _____
 Gas _____
 Oil _____
 Total Depth _____

PRODUCTION

1st 24 hrs. Nat. _____
 1st 24 hrs. after shot _____
 Gas _____ Cu. Ft.
 Dry Hole _____
 Abandoned _____

Date

FEB - 3 1917

191

E. H. WEST Scout

Cowley
 Map No. _____ Sec. *24* Twp. *30* R. *3*
 Well No. *1 Houser* Farm _____
 _____ *Commonwealth* Company

NORTH



SOUTH

Location _____
 Rig Up _____
 Drilling and remarks

*Plugging and
 pulling pipe*

RECORD

Cased _____ in. _____ Ft.
 Sand _____
 Gas _____
 Oil _____
 Total Depth *3008*

PRODUCTION

1st 24 hrs. Nat. _____
 First 24 hrs. after shot _____
 Gas _____ Cu. Ft.
 Dry Hole
 Abandoned

Date *2/6/17* 191 _____

E. West Scout