

Section 6 Township 15 Range 13WWell No. #3 BenderCompany Jones, Shelburne & Farmer

NORTH

SOUTH

Russell

KANSAS

Sec. 6 Twp. 15 R. 13 W ✓

Well No. # 3 Bender Farm

Jones, Shelburne & Farmer Company

Contractor

Trapp


Ft. from N. Line

990 Ft. from S. Line

330 Ft. from E. Line

Ft. from W. Line

NE SE SW

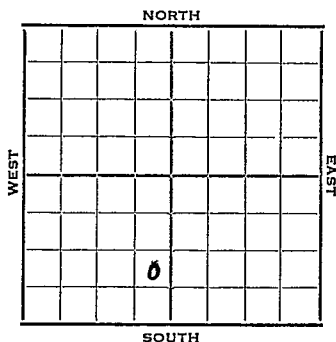


1952 Elev. 1835' REPORT

4/30 Spud 4-29-52
5/7 8" @ 120' Anhy 815'
Drilg. 2802'
5/14 Topeka 2888 Heeb. 2940 Tor 2955
Douglas 2972 Lans. 3005
DST 3036-57 1 hr. 45' HOCM
BKC 3216 Arb. 3279
RTD 3282 SO 5" @ 3280
5/20 CO 3282' NS DD 3287' Fill up 300'
oil 3 hr. S/3 BOPH for 3 hrs.
1000 A S/6 BOPH for 4 hrs. POP
5/28 NR
6/4 Spd 4-29-52
Oil Well TD 3287
8" @ 120 Anhy 815
Top. 2888 Heeb. 2940
Tor. 2955 Doug 2972
Lans. 3005
DST 3036-57 opn 1 hr.
Rec 45' hocm BKC 3216
Arb. 3279 TD 3282
5" @ 3280 DD 3287
FU 300' oil 3 hr.
S/3 boph 1000 A S/6 boph
Comp. 50 bopd

COMPLETED

County Russell State Kansas
 (Blk.) (Sur.)
 Sec. 6 15 13W Map No.
 (Twp.) (Rge.)
 Operator Jones, Shelburne & Farmer
 Well No. 3 Farm Bender
 Elev. Location NE SE SW

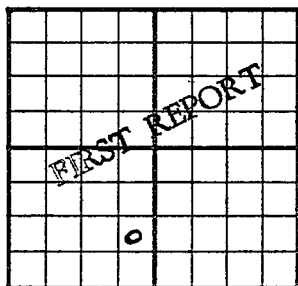

990 Ft. From S Line SW
330 Ft. From E Line Quarter
 Ist. Report APR 30 1952

Completion


Remarks

Spudding Date 4-29-52

Drlg. Data

Trapp

J. G. McGEHEE

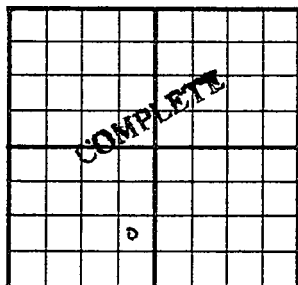County Russell State KansasSec. 6 (Blk. Twp.) 15 (Sur. Rge.) 13W Map No.Operator Jones, Shelburne & FarmerWell No. 3 Farm BenderElev. 1835 Location NE SE SW990 Ft. From S Line SW330 Ft. From E Line Quarter

1st. Report

Completion JUN 4 1952Remarks Trapp PoolSpudding Date 4-29-52Drilg. Data Oil well TD 32878" @ 120 Anhy 815 Top. 2888Heeb. 2940 Tor. 2955 Doug. 2972Lens. 3005 DST 3036-57 open 1 hr.Rec. 45' hoam B KC 3216 Arb. 3279TD 3282 5" @ 3280 DD 3287 FU 300' oil3 hr. S/ 3 boph 1000 A S/ 6" bophComp. 50 bopd

J. G. McGEHEE