


Section 6 Township 15 Range 13W

Well No. #1 Bender

Company Jones, Shelborne & Farmer

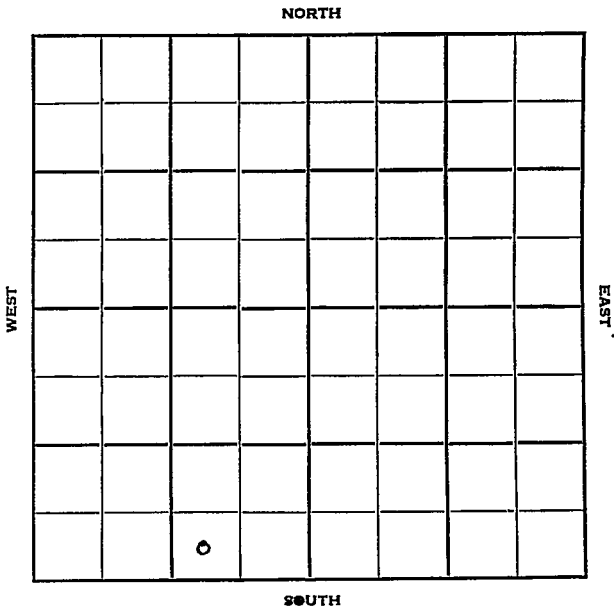

Russell

**KANSAS**

Sec. 6 Twp. 15 R. 13W

Well No. #1 Bender Farm

Jones, Shelborne & Farmer Company

Sauvage & Dunne Contractor

Trapp Pool


         Ft. from N. Line

330 Ft. from S. Line

990 Ft. from E. Line

         Ft. from W. Line

SW SE SW

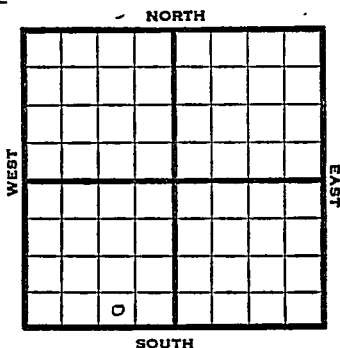

1951	Elev. 1847' REPORT
11/21	RUR
1952 1/9	Spud 11-23-51
	Oil well TD 3297' 8" @ 123
	Anhy 595' Heeb 2951' Tor. 2970'
	KC 3016' Arb. 3293-97
	5" @ 3294' CO to 3297' B/3 Bailers
	oil 1 hr. 500 A S/20 BOPH
	Comp. 80 BOPD
	<b>COMPLETED</b>



