


Section 5 Township 15 Range 13-W

Well No. #1 "C"  
#4 Gross "A"

Company Shields etal

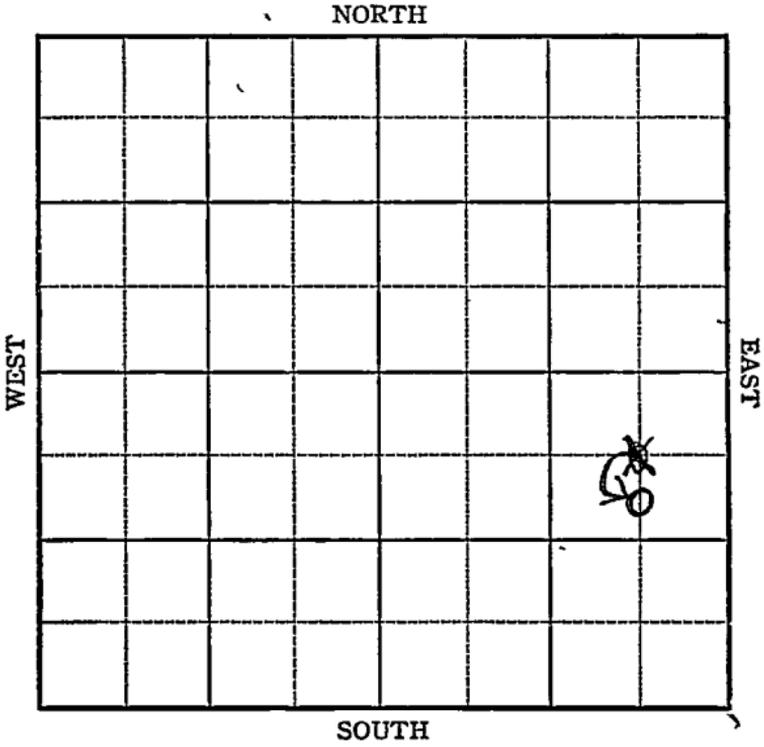

Sec. 5 Twp. 15 R. 13-W

Well No. ~~#1~~ <sup>#1</sup> Gross "A" "C" Farm

Shields etal Company

990


~~660~~ Ft. from N. Line

\_\_\_\_\_ Ft. from S. Line

660 Ft. from E. Line

\_\_\_\_\_ Ft. from W. Line

Elev. 1781

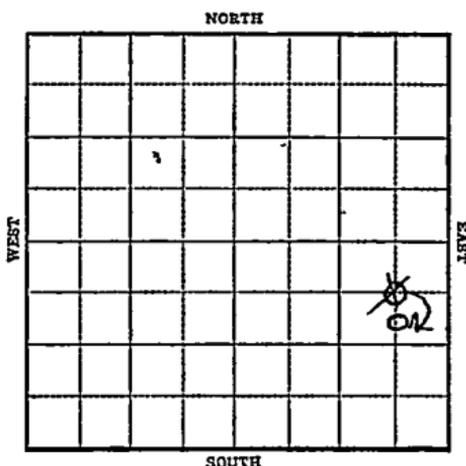

1943

R E P O R T

10/27 Cable

11/3 Cable rig

11/10 15" @ 60  
12" @ 398  
Drlg. 475'

11/17 Anhy 763  
10" @ 770  
Drlg. 1400'

11/24 Drlg. 2375'

12/1 8" @ 2400  
Topeka 2775  
Dodge 2918-2972  
Run 6"

12/8 Lans 2967  
TD 3020 SO  
6" @ 2972'

12/15 6" @ 2972  
Lans 2967  
5000 acid  
Pump 317 pot.  
TD 3020  
Grav. 39.4

COMPLETED

Map No. 73 Sec. 5 Twp. 15 R. 13W

Well No. 4 Gross "A"

Shields etal. Company

FIRST REPORT

Contractor

C NE SE

SECTION PLAT

660 Ft. from N. Line

\_\_\_\_\_ Ft. from S. Line

660 Ft. from E. Line

\_\_\_\_\_ Ft. from W. Line

			o

Hall-Gurney Pool

Location \_\_\_\_\_

Rig up \_\_\_\_\_

Drilling and Remarks:

Cable

RECORD

Cased \_\_\_\_\_ in., \_\_\_\_\_ ft.

Sand \_\_\_\_\_

Gas \_\_\_\_\_

Oil \_\_\_\_\_

Total Depth \_\_\_\_\_

PRODUCTION

1st 24 hrs. Nat. \_\_\_\_\_

1st 24 hrs. after shot \_\_\_\_\_

Gas \_\_\_\_\_ Cu. Ft.

Dry Hole \_\_\_\_\_

Abandoned \_\_\_\_\_

Date

OCT 27 1943 19

S. J. LEWIS Scout

Russell

KANSAS 3 Map No. 3 Sec. 5 Twp. 15 R. 13W

Well No. 1 Gross "C"

Shields et al. Company

CORRECTION Contractor

C S L NE SE

990 Ft. from N. Line

Ft. from S. Line

660 Ft. from E. Line

Ft. from W. Line

SECTION PLAT

			o

Hall-Gurney Pool

Location

Rig up

Drilling and Remarks:

Reported 4 Gross "A" C NE SE

RECORD

Cased in. ft.

Sand

Gas

Oil

Total Depth

PRODUCTION

1st 24 hrs. Nat.

1st 24 hrs. after shot

Gas Cu. Ft.

Dry Hole

Abandoned

Date

NOV 3 1943

19

S. J. LEWIS

Scout

Russell

KANSAS

Map No. 73 Sec. 5 Twp. 15 R. 13W

Well No. 1 Gross "C"

Shields et al. Company

COMPLETED Contractor

C S L N E S E

SECTION PLAT

990 Ft. from N. Line

\_\_\_\_\_ Ft. from S. Line

660 Ft. from E. Line

\_\_\_\_\_ Ft. from W. Line

			o

Hall-Gurney Pool

Location \_\_\_\_\_

Rig up \_\_\_\_\_

Drilling and Remarks:

*Lane 2967  
6 "C 2972  
5000 cu ft  
Pump. 817 P.D.*

*894 8/11*

RECORD

Cased \_\_\_\_\_ in., \_\_\_\_\_ ft.

Sand \_\_\_\_\_

Gas \_\_\_\_\_

Oil \_\_\_\_\_

Total Depth 3020

PRODUCTION

1st 24 hrs. Nat. \_\_\_\_\_

1st 24 hrs. after shot \_\_\_\_\_

Gas \_\_\_\_\_ Cu. Ft.

Dry Hole \_\_\_\_\_

Abandoned \_\_\_\_\_

Date

DEC 15 1943 19

S. J. LEWIS Scout