


KANSAS Russell

FORM 51 5M PETROL

Section 5 Township 15 Range 13W

Well No. ~~4 Gross~~ 2 Draw "B"

Company R. H. Shields

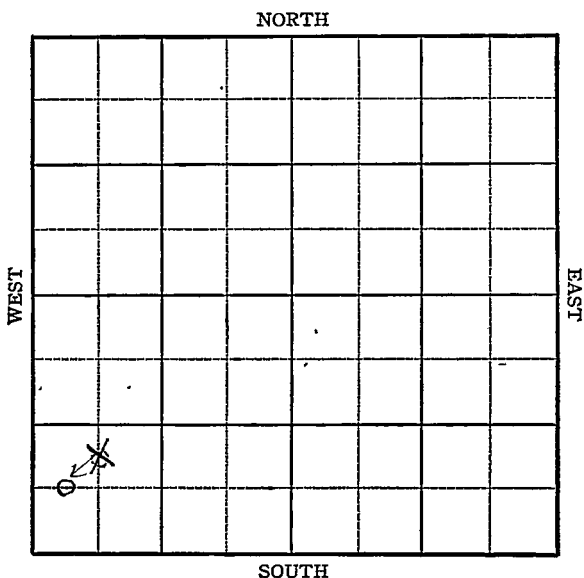

Sec. 5 Twp. 15 R. 13-W

Well No. #2 Gross "B" Farm

R. H. Shields Company

 Ft. from N. Line


660
~~990~~ Ft. from S. Line

 Ft. from E. Line

330
~~660~~ Ft. from W. Line

CWL SW SW

C-N-L-SW-SW Elev. 1791

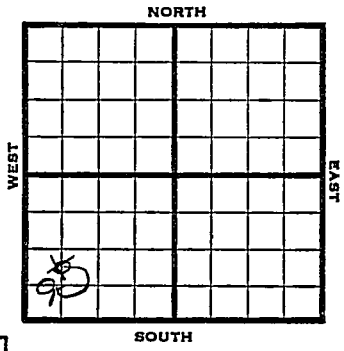

1945		REPORT
9/12		Cable
9/19		15" @ 22 Drlg. 130'
9/26		12" @ 402 Drlg. 490
10/3		Anhy. 788 10" @ 798 Drlg. 1200'
10/10		Drlg. 2135
10/17		8" @ 2395 Drlg. 2485
10/24		8" @ 2526 Drlg. 2615
10/31		Lans 2985 6. @ 3008 Drlg. 3150
11/7		Arb. 3266 DD 3280
11/14		" "
11/21		" "
11/28		TD 3330 HFW
12/5		" " "
12/12		Arb. 3266 TD 3300'

ABANDONED

KANSAS

Kansas

Pool Name Trapp

Map No. 73 Sec. 5 Twp. 15 R. 13W

Well No. 4 Gross

R. H. Shields Company

CORRECTION Contractor

C W L SW SW

SECTION PLAT

 Ft. from N. Line

660 Ft. from S. Line

 Ft. from E. Line

330 Ft. from W. Line

Russell

Location

Rig up

Drilling and Remarks:

reported

C N L SW SW

RECORD

Cased in., ft.

Sand

Gas

Oil

Total Depth

PRODUCTION

1st 24 hrs. Nat.

1st 24 hrs. after shot

Gas Cu. Ft.

Dry Hole

Abandoned

Date

SEP 26 1945

19

S. J. LEWIS

Scout

KANSAS

Kansas Pool Name Trapp

Map No. 73 Sec. 5 Twp. 15 R. 13W

Well No. 2 Grose "B"

R. H. Shields Company

CORRECTION Contractor

C W L SW SW

SECTION PLAT

 Ft. from N. Line

660 Ft. from S. Line

 Ft. from E. Line

330 Ft. from W. Line

		•	
o			

Russell

Location

Rig up

Drilling and Remarks:
reported 4 Gross.

RECORD

Cased in., ft.

Sand

Gas

Oil

Total Depth

PRODUCTION

1st 24 hrs. Nat.

1st 24 hrs. after shot

Gas Cu. Ft.

Dry Hole

Abandoned

Date

OCT 10 1945 19

S. J. LEWIS Scout

