


Section 29 Township 30 Range 3 E

Well No. # 1 Hand

Company Bowman & Grissmore

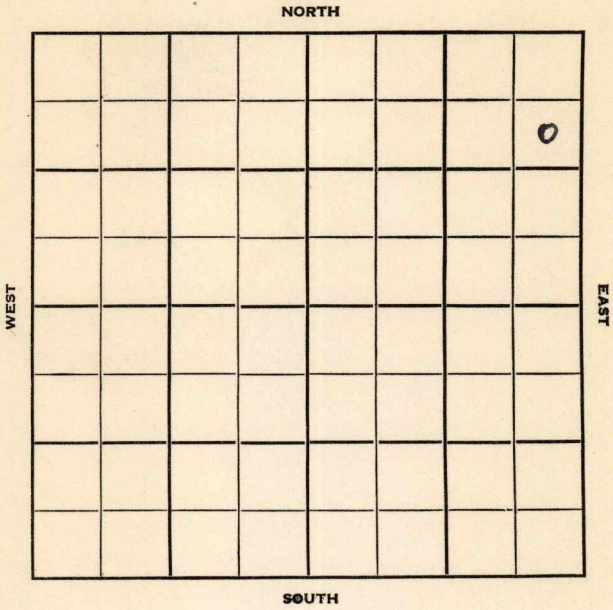

Sec. 29 Twp. 30 R. 3 E

Well No. # 1 Hand Farm

Bowman & Grissmore Company


Greeley Contractor

990 Ft. from N. Line

_____ Ft. from S. Line

330 Ft. from E. Line

_____ Ft. from W. Line

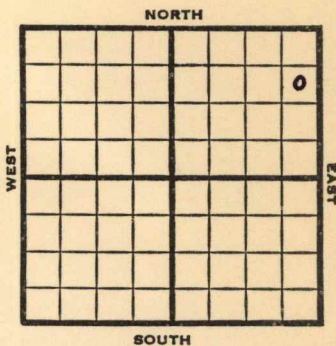

SE NE NE

1953

Elev. 1254'

REPORT

6/24

Spud 6-7-53

8" @ 85 TD 1842'

5" @ 1842

7/15

Spud 6-7-53

Oil Well

TD 1842'

8" @ 85'

TD 1842'

5" @ 1842'

P/ 15 bopd **Hoover 1800**

Perf. 1804-08

Comp. 15 bopd.

COMPLETED

