


Barton

KANSAS

SECTION 36 TOWNSHIP 16 RANGE 12 W

WELL NO. #1 Hoffman

COMPANY Bebbs Drlg.

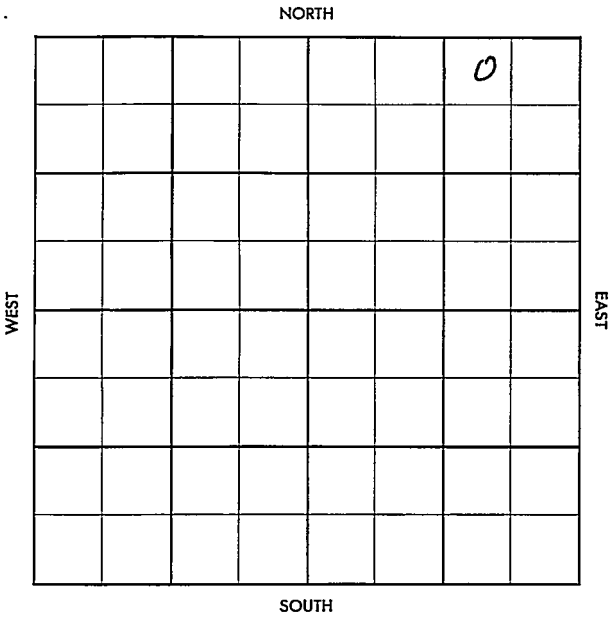

County Barren Elev. _____
 Sec. 35 Twp. 16 Rge. 12W
 Company Babbs Drilling
 FarmName Hoffman No. I

TOPS	DEPTH	LOG	DATUM
Anb.			
Ip.			
H.			
Tr.			
Dg.			
Bl.			
L.			
K.C.			
B.K.C.			
Ce.			
C.			
M.			
M.			
K.			
Mz.			
Me.			
V.			
S.			
S.			
A.			
R.			
Pe.			
G.			
T.D.			

Loc. in Sec. NW NE NE
 Geol. _____
 Contr. A. L. Jackson
 Pool Kraft-Prusa

		6

 FIRST REPORT
 DEC 21 1955

Date Comm. 12-11-55
8" @ 225 drlg. 2800

Co.
 Lse.
 No.
 Sec.
 T.
 R.

[Handwritten signature]

County Barton Elev. 1899
 Sec. 36 Twp. 76 Rge. 12W
 Company Babbs Drig.
 FarmName Hoffman No. 1

TOPS	DEPTH	LOG	DATUM
Anh.			
TP.	2677		778
H.	2916 1/2		1067
Tr.	2984		1085
Dg. <i>sd</i>	3004		1105
Bl.	3064		1165
L.	3080		1181
K.C.			
B.K.C.			
Ce.			
C.			
M.			
M.			
K.			
Mz.			
Me.			
V.			
S.			
S.			
A.			
R.			
PE.			
G.			
T.D.	3350		

Loc. in Sec. NW NE NE

Geol. _____
 Contr. A.L. Jackson

Pool Kraft-Prusa

		0
ABANDONED		

Date Comm. 12-14-55 JAN 1 1 1956

8" @ 225 5 1/2" @ 3100 CO 3/ 3008-16

B/ 5 gwph scum oil frac

Temp. abd.

Co.
 Use.
 No.
 Sec.
 T.
 R.