


Section 28 Township 30 Range 3 E

Well No. # 1 Minson

Company Bert Ash & Son

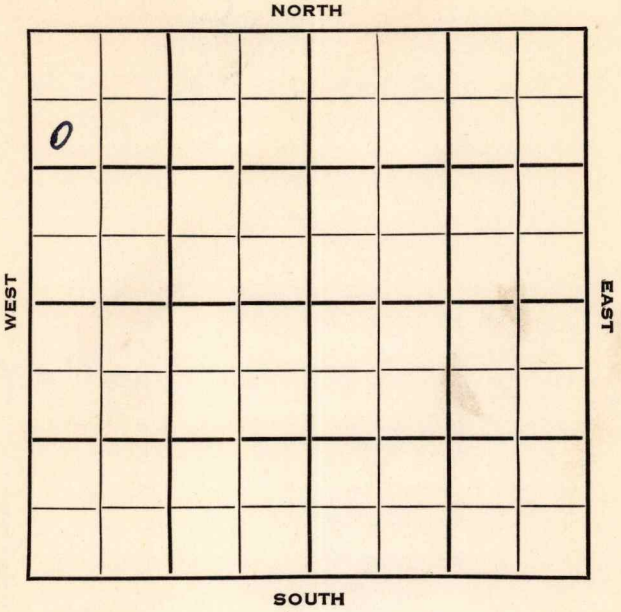

Sec. 28 Twp. 30 R. 3E

Well No. #1 Minson Farm

Bert Ash & Son Company

Martin Drlg. Contractor

Udall Pool


990 Ft. from N. Line

_____ Ft. from S. Line

_____ Ft. from E. Line

330 Ft. from W. Line

SW NW NW

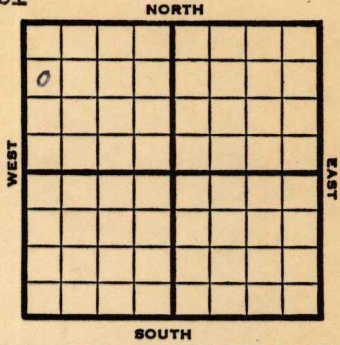

1953 **Elev. 1241'** REPORT

8/26 Spud 8-21-53
 8" @ 107'
 Drlg 1480'

10/7 Spud 8-21-53
 Oil Well
 TD 1806'
 8" @ 107'
Hoover 1787
 TD 1806'
 5" @ 1787'
 CO to 1806'
 sd-frac
 P/ 40 bo
 Comp 40 bopd.

COMPLETED

County Cowley State Kansas

Sec. 28 (Blk. Twp.) 30 (Sur. Rge.) 3E Map No.

Operator Bert Ash & Son

Well No. 1 Farm Minson

Elev. Location SW NW HW

0							

990 Ft. From N Line NW

330 Ft. From W Line Quarter

1st. Report AUG 26 1953

Completion _____

Remarks _____

Martin Drlg. - Contr.

Spudding Date 8-21-53

Drlg. Data. Udall Pool

8" @ 107 drlg. 1480

