


Section 35 Township 16 Range 12W

Well No. #2 Kerkisch (Korkisch)

Company Geo. Hess et al

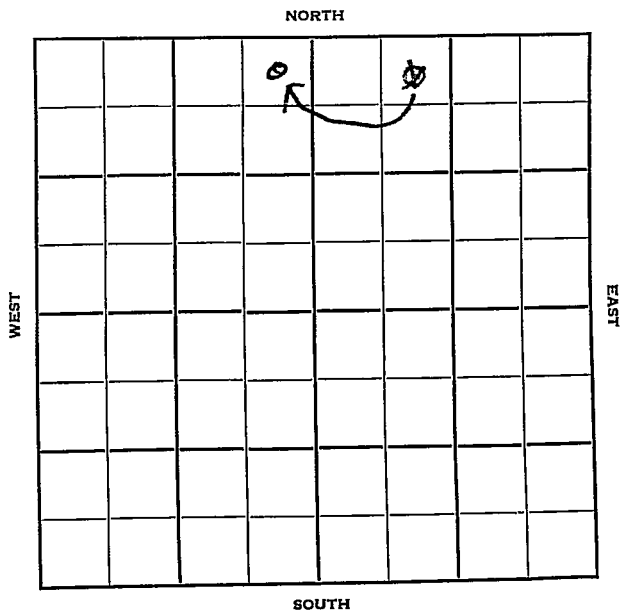

Sec. 35 Twp. 16

Well No. #2 Korkisch Farm

Geo. Hess et al Company

Mallard Drlg. Contractor


330 Ft. from N. Line

Ft. from S. Line

330 Ft. from E. Line

Ft. from W. Line

NW  $\frac{1}{4}$  NENE NW

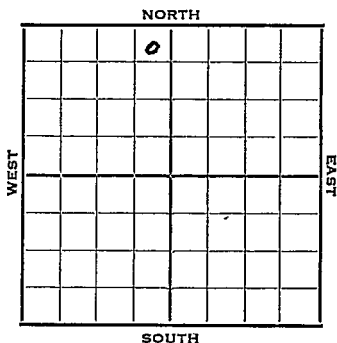

1952

Elev. 1928'

REPORT

10/22

RUR

10/29

8" @ 300  
Drlg. 2676'

11/5

Spud 10-23-52  
D&A TD 3425' 8" @ 300'  
Heeb. 3012 Br Li 3111  
Lans. 3122 Cong. 3378  
DST 3413-25 open 1 hr. rec. 330' sw  
& SO 1005# TD 3425' D&A

**ABANDONED**



County Barton State Kansas

Sec. 35 (Blk. 16) (Sur. 12W) (Twp. 16) (Rge. 12W) Map No.

Operator Geo. Hess et al.

Well No. 2 Farm Korkisch

Elev. 1928 Location NE NE NW

<b>CORRECTION</b>					
<b>ABANDONED</b>					

330 Ft. From N Line NW

330 Ft. From E Line Quarter

1st. Report

Completion NOV 5 1952

Remarks

Mallard Drlg. - Contr.

Spudding Date 10-23-52

Drlg. Data D & A TD 3425

8" @ 300 Heeb. 3012 Br. lime 3111

Lans. 3122 Cong. 3378 DST 3413-25

open 1 hr. Rec. 330' sw & SO 1005#

TD 3425

D & A