

Barton

KANSAS

35

16

12W

SECTION _____ TOWNSHIP _____ RANGE _____

WELL NO. #1 Korkish

COMPANY Petroleum Inc.

NORTH

WEST

EAST

SOUTH

Barton

KANSAS

SEC.	TWP.	R.
35	16	12W

WELL NO.

#1 Korkish

FARM

COMPANY

Petroleum Inc.

CONTRACTOR

Garvey

S. Beaver


Ft. from N. Line

Ft. from S. Line

Ft. from E. Line

Ft. from W. Line

NW SW NW

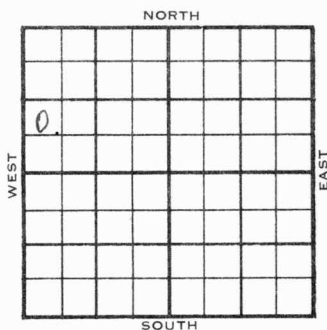

1956

ELEVATION

1910 RB

REPORT

4-18

Comm. 4-10-56

8" @ 210 w/150

DST 3086-3168 op 1 hr. rec. 260' wtry m
mud, 970/20"

Drlg. 3347

Anh. 800

Tp. 2705

H. 2992

Tr. 3008

Dg. 3019

BL 3084

L. 3099

4-25

DST 3380-85 op 1 hr. rec. 8' mud,
BHP 100#.DST 3385-94 op 1 hr. rec. 25' mud,
BHP 800#.

D & A

C. 3359

Cg. Chert 3364

A. 3378

TD 3403'

ABANDONED

County Barton Elev. 1910 RB
 Sec. 35 Twp. 16 Rgs. 12W
 Company Petroleum Inc.
 Farm Name Kerkish No. 1

TOPS	DEPTH	LOG	DATUM	Loc. in Sec.
Anh.	800			NW SW NW
Tp.	2705			
H.	2992			
Tr.	3008			
Dg.	3019			
BL.	3084			
L.	3099			
K.C.				Geol.
B.K.C.				Contr.
Ce.				Garvey
C.				
M.				Pool
M.				S. Beaver
K.				
Mz.				
Mq.				
V.				
S.				
S.				
A.				
R.				
PE.				
G.				
T.D.				

Date Comm. 4-10-56
8" @ 210/150 DST 3086-3168 open 1 hr.
rec. 260' w try mud 970/20" drlg. 3347

APR 5 1956

R. G.

Co.

Lse.

No.

Sec.

T.

R.

FIRST REPORT

County Barton Elev. 1910 RB Co. 1
 Sec. 35 Twp. 16 Rge. 12W 190807
 Company Petroleum Inc.
 Farm Name Korlish No. 1

TOPS	DEPTH	LOG	DATUM	Loc. in Sec.
Anh.	300			NW SW NW
TP.	270			
H.	2952			
Tr.	3008			
Dg.	3018			
BL.	3001			
L.	3000		1189	Geol.
K.C.				Contr.
B.K.C.				
Ce.				
C.	3359		1449	Garvey
M. c9 chert	3364		1454	
M.				Pool
K.				S. Beaver
Mz.				
Mq.				
V.				
S.				
S.				
A.	3378		1468	
R.				
PE.				
G.				
T.D.	3403			

Date Comm. 11-10-56 APR 25 1956
8" @ 210/150 DST 3085-3160 open 1 hr.
rec. 260' w try mud 970/20" tlc. 3317
APR 25 '56 DST 3380-85 1 hr rec 8'
Md BHP 100 DST 3385-94 1 hr
rec. 25' Md BHP 800

D&A