


Cawley

Map No. **KANSAS** Sec. *28* Twp. *30* R. *3E*

Well No. *1 - Sloan's* Farm
Blankenship Pet Company

NORTH

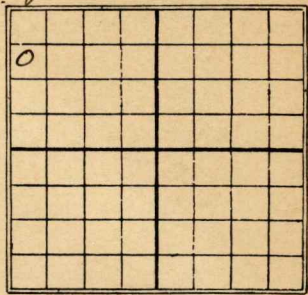

990 Ft. from N. Line

_____ Ft. from S. Line

_____ Ft. from E. Line

330 Ft. from W. Line

1930

Date	REPORT
<i>3/19</i>	<i>ROD</i>
<i>3/26</i>	<i>Bldg rig</i>
<i>4/2</i>	<i>Spdg.</i>
<i>4/9</i>	<i>" 300'</i>
<i>4/16</i>	<i>hdlg 540'</i>
<i>4/23</i>	<i>Fdg 750'</i>
<i>4/30</i>	<i>Wdg 1150'</i>
<i>5/7</i>	<i>8" 1430'</i>
<i>5/14</i>	<i>Sand 1790-1820'</i>
<i>5/21</i>	<i>show hdlg. 1840'</i>
<i>5/28</i>	<i>6" - 2007 hdlg.</i>
<i>6/4</i>	<i>2084'</i>
<i>6/11</i>	<i>Sand 2080-89</i>
<i>6/18</i>	<i>N7W - S.D.</i>
<i>6/25</i>	—
<i>7/2</i>	—
<i>7/9</i>	<i>Sand 2080-2150</i>
<i>7/9</i>	<i>N7W hdlg</i>

~~6/25 - 6" - 3689'~~

~~Clg. out 3692'~~

7/16 - U.P. 6" - 2465'

7/23 - Wdly. 2860'

7/30 - Top line 2875-77
1100' oil in hole.

8/6 - Top line 2865-73
25 bbl show
dry 2902'

8/13 - SD 2918'

8/20 - TD 3002'

P.B. to 2875

shot 15 qt - Dry out

8/27 - Req. tubing

9/3 —

9/10 —

9/17 - SD 2875'

9/24 —

10/11 - Made 15 bbls oil
and 4 " water

10/18 —

10/15 —

10/22 - May abandon

10/29 — 12/23 —

11/5 — 12/30 —

11/12 — 1931

11/19 — 117 - Had 15 bbl

11/26 — show 2865-73

12/3 — T.D. 3002

12/10 — dry & abandon

12/17 —

12 **KANSAS** Sec. *28* Twp. *30* R. *3^E*

Well No. *1* *Shean*

Blankenship Pat Company

Contractor

FIRST REPORTS

SECTION PLAT

990 Ft. from N. Line

..... Ft. from S. Line

..... Ft. from E. Line

330 Ft. from W. Line

<i>0</i>			

Location *Pro 4*

Rig up

Drilling and Remarks:

RECORD

Cased..... in., ft.

Sand.....

Gas.....

Oil.....

Total Depth.....

PRODUCTION

1st 24 hrs. Nat.....

1st 24 hrs. after shot.....

Gas..... Cu. Ft.

Dry Hole.....

Abandoned.....

Date

MAR 19 1930

CHAS. L. SHERWOOD

..... 192.....

..... Scout

Cowley

Map No. **KANSAS** Sec. *28* Twp. *30* R. *3*

Well No. *1* *Shaw*

Blankenship Company

Put Contractor

COMPLETE

SECTION PLAT

990 Ft. from N. Line

..... Ft. from S. Line

..... Ft. from E. Line

330 Ft. from W. Line

<i>0</i>			

ABANDONED

Location.....

Rig up.....

Drilling and Remarks:

*15 bl Shaw
2865-2873*

RECORD

Cased..... in., ft.

Sand.....

Gas.....

Oil.....

Total Depth *2002*

PRODUCTION

1st 24 hrs. Nat.....

1st 24 hrs. after shot.....

Gas..... Cu. Ft.

Dry Hole

Abandoned

Date

JAN 7 1931

CHAS. L. SHERWOOD

..... 192..... Scout