


Section 36 Township 16 Range 12-W

Well No. #1 Hoffman

Company Armer & Vernon

Beaver Pool

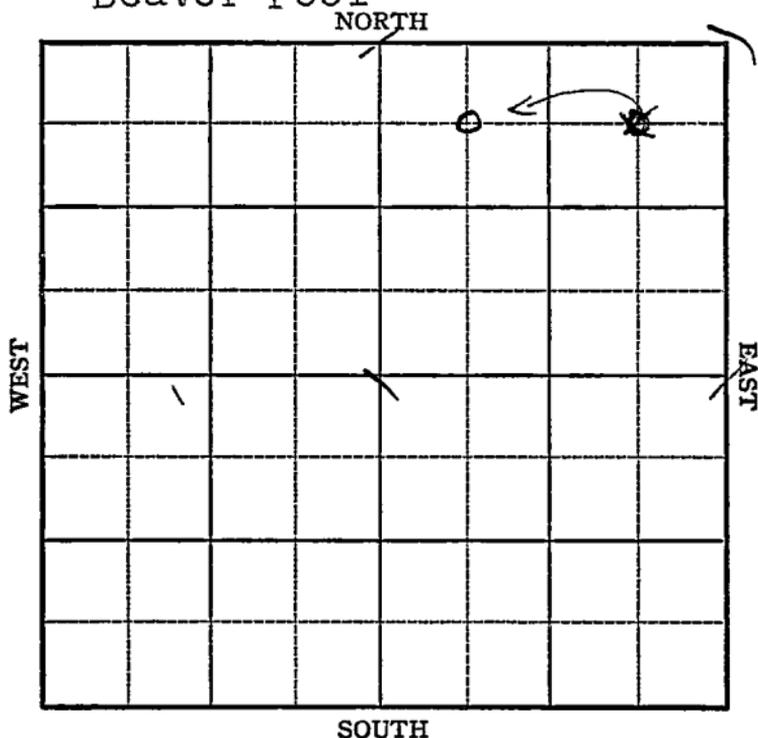

Sec. 36 Twp. 16 R. 12-W

Well No. #1 Hoffman Farm

Armer & Vernon Company

(Beaver Pool)


660 Ft. from N. Line

_____ Ft. from S. Line

660 Ft. from E. Line

660 Ft. from W. Line

Elev. 1929

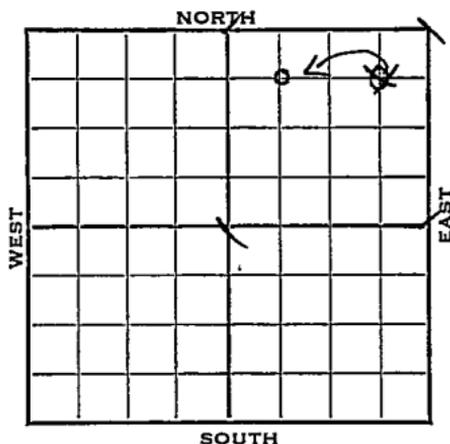

1942

REPORT

9/2	Cellar
9/9	"
9/16	"
9/23	"
9/30	"
10/7	"
10/14	Cable
10/21	"
10/28	"
11/4	"
11/11	Rigging up.
11/18	Drlg. 1635 12" @ 470 Anhy 789 10" @ 789
11/24	Drlg. 2310' 8" @ 2170'
12/2	Topeks 2715 Drlg. 3000
12/9	Lams. 3117 Cong 3363 arb 3374 TD 3390 1/2 S0 5 1/2" @ 3384 1/2 WOC

OVER

1942

12/16 Lans 3105
Corg 3348
Arb. 3365
Corrected
5" @ 3370
TD 3380-600 oil in 12 hrs
1500 acid.

12/22 Arb. 3365
5" @ 3370'
T.D. 3380'
1500 gals. acid.
Pump 336 Pot.
Gravity 39

COMPLETED

Map No. 55 Sec. 36 Twp. 16 R. 12WWell No. 1 HoffmanArmer & Vernon

Company

FIRST REPORT

Contractor

C NE NE


660 Ft. from N. Line

Ft. from S. Line

660 Ft. from E. Line

Ft. from W. Line

SECTION PLAT

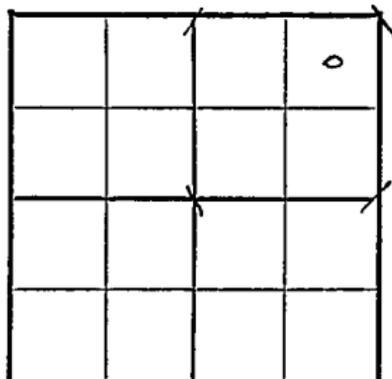**BEAVER POOL**

Location _____

Rig up _____

Drilling and Remarks:

Cellar

RECORD

Cased _____ in., _____ ft.

Sand _____

Gas _____

Oil _____

Total Depth _____

PRODUCTION

1st 24 hrs. Nat. _____

1st 24 hrs. after shot _____

Gas _____ Cu. Ft.

Dry Hole _____

Abandoned _____

Date

SEP 2 1942 19 _____

S. J. LEWIS Scout

Barton

KANSAS

Map No. 55 Sec. 36 Twp. 16 R. 12WWell No. 1 HoffmanArmer & Vernon CompanyCORRECTION Contractor

C NW NE

SECTION PLAT

660 Ft. from N. Line

_____ Ft. from S. Line

_____ Ft. from E. Line

660 Ft. from W. Line

		0	

BEAVER POOL

Location _____

Rig up _____

Drilling and Remarks: _____

Reported

C NE NE

RECORD

Cased _____ in., _____ ft.

Sand _____

Gas _____

Oil _____

Total Depth _____

PRODUCTION

1st 24 hrs. Nat. _____

1st 24 hrs. after shot _____

Gas _____ Cu. Ft.

Dry Hole _____

Abandoned _____

Date

OCT 14 1942 19S. J. LEWIS Scout

Barton

KANSAS
 Map No. 35 Sec. 36 Twp. 16 R. 12W

Well No. 1 Hoffman

Armer & Vernon Company

COMPLETED Contractor

C NW NE

SECTION PLAT

660 Ft. from N. Line

_____ Ft. from S. Line

_____ Ft. from E. Line

660 Ft. from W. Line

		o	

BEAVER POOL

Location _____

Rig up _____

Drilling and Remarks:

*On 83365
 5" @ 3370
 1500 @ well
 Pump 836 P. X.*

39° SW

RECORD

Cased _____ in., _____ ft.

Sand _____

Gas _____

Oil _____

Total Depth 3380

PRODUCTION

1st 24 hrs. Nat. _____

1st 24 hrs. after shot _____

Gas _____ Cu. Ft.

Dry Hole _____

Abandoned _____

Date

DEC 22 1942 19

S. J. LEWIS

Scout